

WATER SERVICE RECORD

Name Leeland Const.

Service No. 13

Address 34 Greenwood St.

Location Lexington

~~Repair~~ ~~Renewal~~ New Service

COM.2-16-53


Date	Material	Amount	Total	Date	Amount
1/20/53	Labor	1 63		1-16-53 Deposited	20 00
	10% overhead	16	1 79	2-16-53 Paid	1 84
	45' - 3/4" Copper tubing @ .34		15 30		21 84
	1-3/4" Cx 1/2 I.W.H. stop & waste		4 00		NON CHARGE
	1 Hr. Trucking		75	1/20/53 Labor	7 37
			21 84	12' - 3/4" Copper Tubing @ .34	4 08
	TRENCH DUG BY OWNER			1-3/4" C. Corp-cock	4 33
				1-3/4" C x 3/4" C. Sub-cock	4 67
				1- Box & Rod	3 90
				1- 1/2 offset tail piece	50
				1- 1/2 Straight tail piece	50
				1 Hr. Trucking	75
					26 10

DATE _____

TOWN OF LEXINGTON — BOARD OF PUBLIC WORKS

WATER DIVISION

Sketch of Service Here

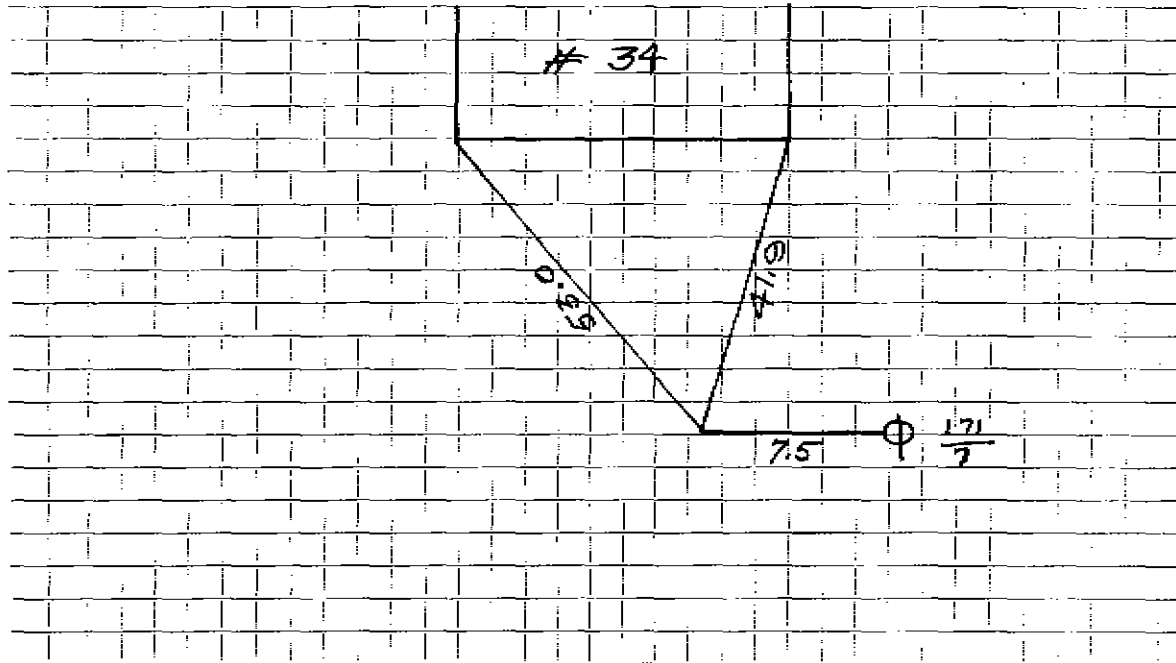

Connection made in Street. Work completed

Remarks:
.....
.....