

#5452

WATER SERVICE RECORD

Name Leeland Const. Co.

Service No. 42

Address 38 Greenwood Street

Location Lexington


RENEWAL - New Service Com. 3/30/53

Date	Material	Amount	Total	Date		Amount
3/6/53	Labor	4 26		2-27-53	Dug out	50 00
	10% overhead	43	4 69	3-30-53	Refilled	(12 96)
	40' - 3/4" copper tubing @ .34		13 60		NON CHARGE	(3) 04
	1 - 3/4" C x $\frac{1}{2}$ I.W.H. stop & waste	4 00	3/6/53 Labor			4 27
	2 hrs. Littlefield shovel @ 7.00	14 00	12' - 3/4" copper tubing @ .34			4 08
	1 hr. trucking	75	1 - 3/4" C.corp-cock			4 33
		37 04	1 - 3/4" Cx 3/4" C.curb-cock			4 67
			1 box and rod			3 90
			1 - $\frac{1}{2}$ straight tail piece			50
			1 - $\frac{1}{2}$ offset tail piece			50
			1 hr. Littlefield shovel			7 00
			1 hr. trucking			75
						30 00

DATE _____

TOWN OF LEXINGTON — BOARD OF PUBLIC WORKS
WATER DIVISION

Sketch of Service Here

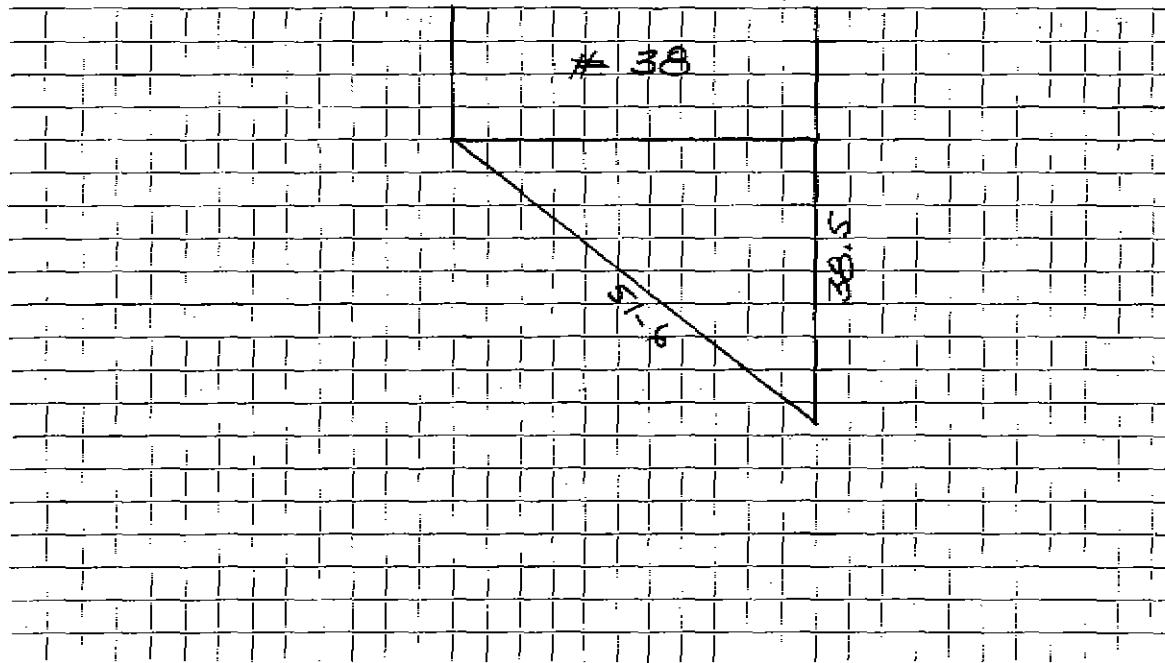

Connection made in Street. Work completed

Remarks:

.....
.....