

WATER SERVICE RECORD

4131

Name Leeland Const.

Service No. 14

Address 39 Greenwood St.

8840

Location Lexington

XXXXXXXXXXXX New Service COM.2-15-53


Date	Material	Amount	Total	Date	Amount
1/20/53	Labor	1 63		1-16-53 Deposited	20 00
	10% overhead	16	1 79	2-16-53 Refunded	52
	35' - 3/4" Copper Tubing @.34		11 22		NON CHARGE 19 48
	1-3/4" C x 1/2" I.W.H. stop & Waste		1 00	1/20/53 Labor	7 37
	1-3/4" C x 3/4" C. Union(3 Parts)		1 72	35' - 3/4" Copper Tubing @.34	11 90
	1 Hr. Trucking		75	1-3/4" C. Corp-cock	4 33
			19 18	1-3/4" C. X 3/4" C. Curb-cock	4 67
	TRENCH DUG BY OWNER			1- Box & Rod	3 90
				1-1/2 offset tail piece	50
				1-1/2 straight tail piece	50
				1 Hr. Trucking	75
					33 92

DATE _____

TOWN OF LEXINGTON — BOARD OF PUBLIC WORKS

WATER DIVISION

Sketch of Service Here

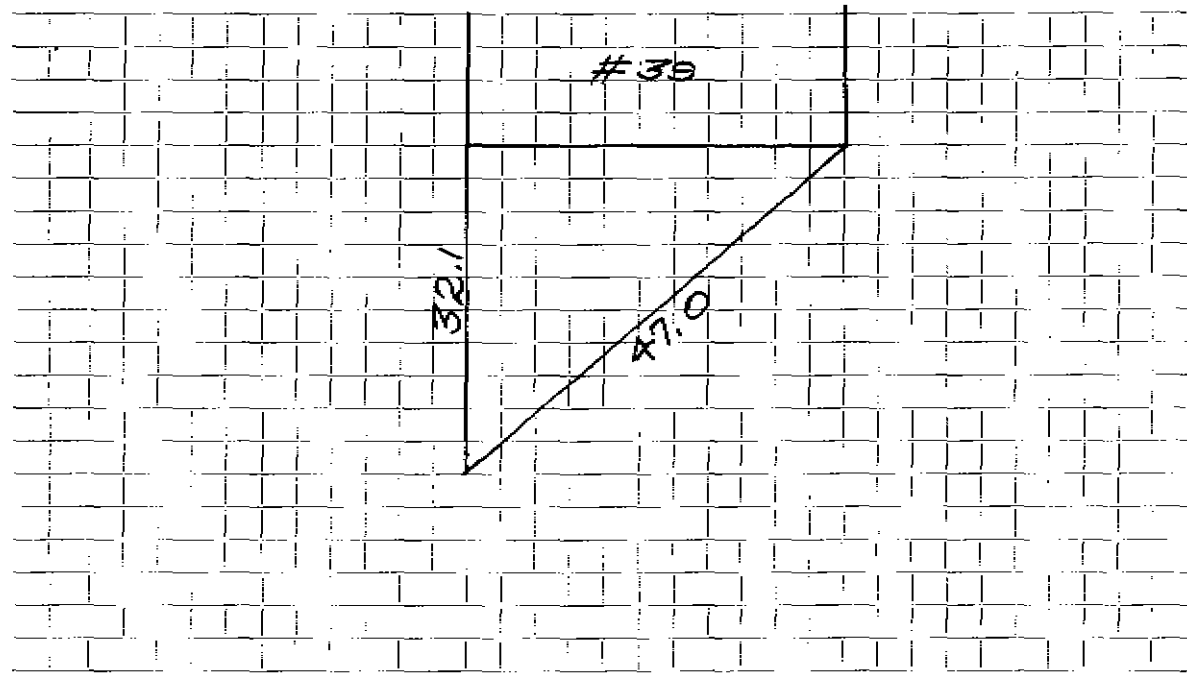

Connection made in Street. Work completed

Remarks:
.....
.....