

WATER SERVICE RECORD

3895
4534

Name Leeland Const. Co.

Service No. 43

Address 42 Greenwood St.

Location Lexington

~~Repair/ Renewal~~ - New Service

Com. 3/30/53

Date	Material	Amount	Total	Date	Amount
3/6/53	Labor	4 26		2-27-53	50 -
	10% overhead	43	4 69	3-30-53	12 96
	40' - 3/4" copper tubing @ .34	13 60			37 04
	1 -3/4" C x 1/2 I.W.H. stop& waste	4 00			
	2 hrs. Littlefield shovel	14 00		3/6/53	4 27
	1 hr. trucking	75		Labor	4 08
		37 04		12' - 3/4" copper tubing @ .34	4 33
				1 -3/4" C corp-cock	4 67
				1 -3/4" C x 3/4" Curb-cock	3 90
				1 box and rod	50
				1 -1/2 straight tail piece	50
				1 -1/2 offset tail piece	7 00
				1 hr. littlefield shovel	75
				1 hr. trucking	30 00

NON CHARGE


* 9.29 of this refund made payable to W. of Tenn. In 1974 by W.D.C. # 45

DATE _____

TOWN OF LEXINGTON — BOARD OF PUBLIC WORKS

WATER DIVISION

Sketch of Service Here

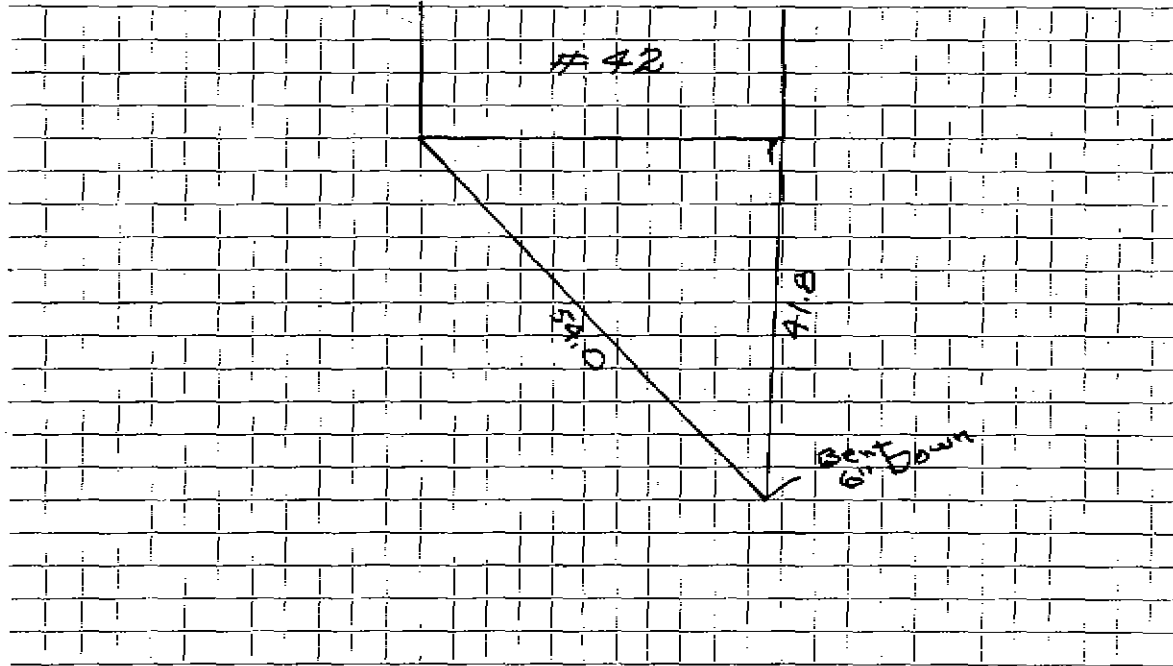

Connection made in Street. Work completed

Remarks:

.....

.....