

WATER SERVICE RECORD

Name Leeland Construction Co.

Service No. 44

Address 44 Greenwood Street

2299

Location Lexington

~~Renewal~~—New Service Com. 3/30/53


Date	Material	Amount	Total	Date	Amount
3/5/53	Labor	8 82		2-27-53	Deposited 50 -
	10% overhead	88	9 70	3-30-53	Refunded (95
	40' + 3/4" copper tubing @ .34		13 60		NON CHARGE 49 05
	1 -3/4" C x 1/2 I.W.H. stop & waste		4 00	3/5/53	Labor \$8 82
	3 hrs. Littlefield shovel		21 00		15' -3/4" copper tubing @ .34 5 10
	1 hr. trucking		75		1 -3/4" C. corp-cock 4 33
			49 05		1 -3/4" C. x 3/4" C. curb-cock 4 67
					1 box and rod 3 90
					1 -1/2 straight tail piece 50
					1 -1/2 offset tail piece 50
					1 hr. Littlefield shovel 7 00
					1 hr. trucking 75
					<u>35 57</u>

DATE _____

TOWN OF LEXINGTON — BOARD OF PUBLIC WORKS

WATER DIVISION

Sketch of Service Here

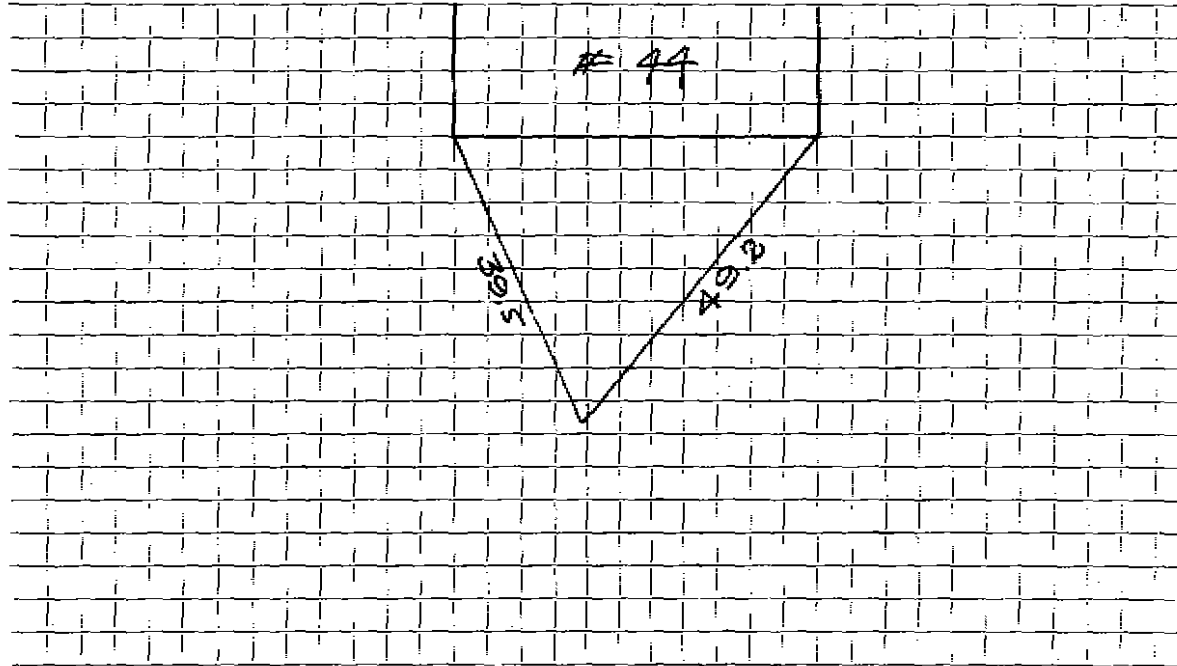

Connection made in Street. Work completed

Remarks:

.....

.....