

WATER SERVICE RECORD

Name Leeland Const. Co.

Service No. 45

Address 45 Greenwood St.

#4616

Location Lexington

~~Repair/Removal~~ - New Service Com. 3/30/53


Date	Material	Amount	Total	Date	Amount
3/9/53	Labor	11 76		2-27-53	Deposited 50 -
	10% overhead	1 18	12 94	3-31-53	Paid (9 29
	40' - 3/4" copper tubing @ .34		13 60		NON CHARGE 59 29
	1 -3/4" cx 1/2 I.W.H. stop& waste		4 00	3/10/53	Labor 17 64
	4 hrs. Littlefield shovel @ 7.00		28 00		20' - 3/4" copper tubing @ .34 6 80
	1 hr. trucking		75		1 -3/4" C. corp-cock 4 33
			59 29		1 -3/4" C x 3/4" C. curb-cock 4 67
					1 box and rod 3 90
					1 -1/2 straight tail piece 50
					1 -1/2 offset tail piece 50
					4 hrs. Littlefield shovel @ 7. 28 00
					1 hr. trucking 75
					67 09

DATE _____

TOWN OF LEXINGTON — BOARD OF PUBLIC WORKS

WATER DIVISION

Sketch of Service Here

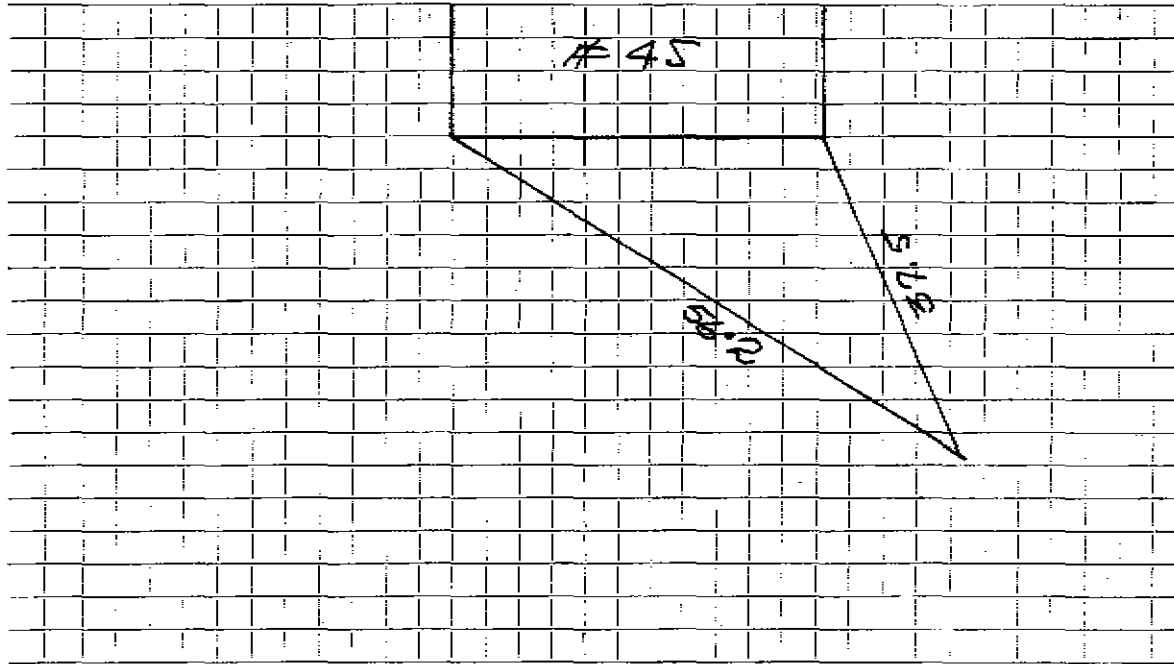

Connection made in Street. Work completed

Remarks:
.....
.....