

Name Royal D. Chandler

Service No.

271

Address 101 Grove Street

Lexington, Mass.

Location 101 Grove Street

Kind of Pipe

Size

Size of Main

Repair—Renewal—New Service

Location

Date	Material	Amount	Total	Date	Amount
Aug. 23, '48	Labor	20	20	Aug 26 '48	30 00
	10% Overhead		2	Nov 5 '48	3 20
	75' - 1" Copper tubing	2.31	22 91		33 20
	1 - 1" 3 x 3/4" U.P.C. (sets)	3 15		Sept. 17, '48	22 57
	1 - 1" 3 x 1" Union (sets)	1 74		35' - 1" Copper tubing	10 85
	Trucking 1 hr.	1.75	75	1 - 1" 3 x 3/4" U.P.C.	3 16
			33 20	1 - 1" 3 x 1" U.P.C.	4 80
				1 - box 4 Rod	3 50
				2 - 3/4" Straight Fall Piece	30
				2 - 3/4" Offset Fall Piece	30
				Trucking 1 hr.	1.75
					47 16

Reported Paid Non-Charge

Electric 10/25/48

trench dug by owner.

Labor

DATE _____

TOWN OF LEXINGTON – BOARD OF PUBLIC WORKS

WATER DIVISION

The undersigned applies for a supply of water at No..... St. and hereby agrees to comply with the rules and regulations as now, or at any future time, established by the Board of Selectmen.

Am't of Estimate \$.....

Owner


Am't Paid \$.....

Address

Builder

.....

Sketch of Service Here

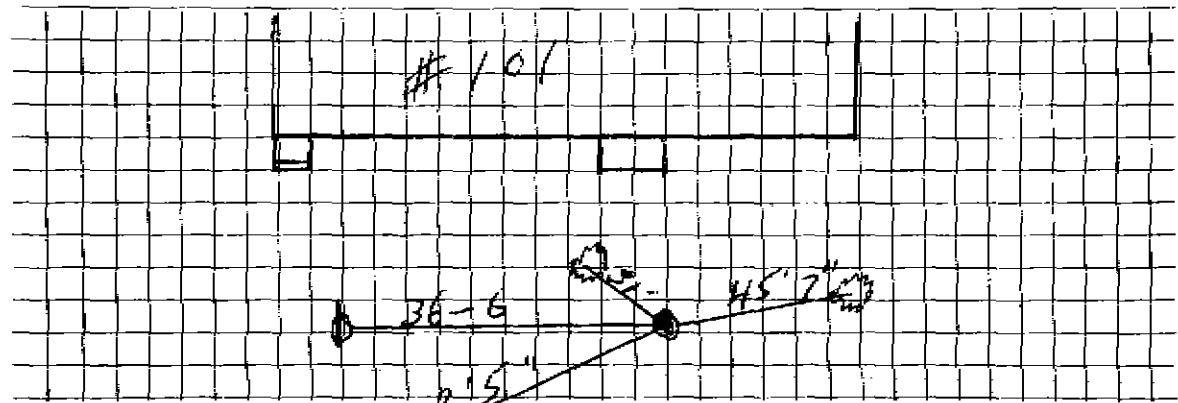

Connection made in Street. Work completed19

Remarks:

Hyd.