

WATER SERVICE RECORD

Name Clymar Bldg., Inc.

Service No. 235

Address 102 Grove Street

# 6883

Location

~~Repair~~ ~~Renew~~ ~~Work~~ New Service

*Cam 9-6-55*


Date	Material	Amount	Total	Date	Amount
8/3/55	Labor	11.28			
	10% overhead	1.13	12.41		
	51'-3/4" copper tubing @.384		19.58		
	1-3/4" Cx 1/2" I.W.H. stop & waste	4.00	15.00		
	2 hrs. Littlefield Shovel @ 7.50		7.50		
	1 hr. trucking @.75		75		
			51.74		
				7-19-55 Deposited	65.00
				9-6-55 Refunded	(13.26)
				<u>NON CHARGE</u>	51.74
				8/3/55- 3'-3/4" copper tubing @.384	1.15
				1-3/4" C corp. cock	4.33
				1-3/4" Cx 3/4C curb-cock	4.67
				1 box and rod	3.90
				1-1/2" straight tail piece	50
				1-1/2" offset tail piece	50
				1 hr. Littlefield shovel @ 7.50	7.50
				1 hr. trucking @.75	75
					23.30

DATE \_\_\_\_\_

TOWN OF LEXINGTON — BOARD OF PUBLIC WORKS

WATER DIVISION

Sketch of Service Here

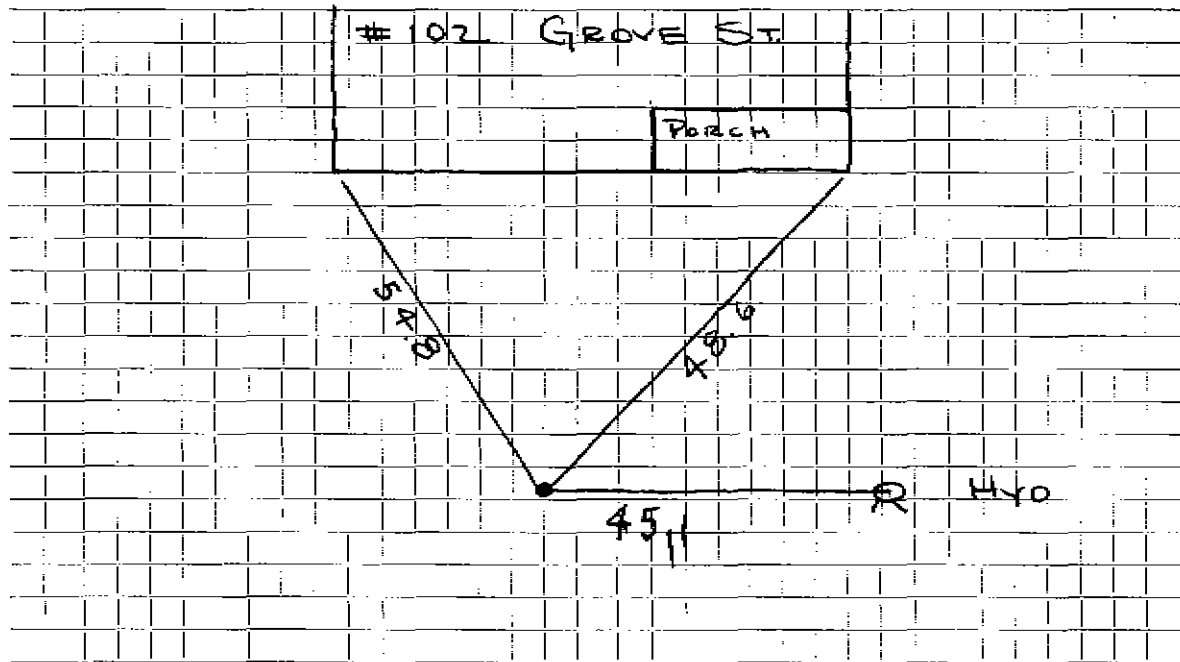

Connection made in ..... Street. Work completed .....

Remarks: .....

.....

.....