

WATER SERVICE RECORD

# 5631

Name Clyman Builders, Inc.

Service No. 65

Address 106 Grove Street

Location \_\_\_\_\_

Repair  Renewal  New Service


*Com. 5-3-54*

Date	Material	Amount	Total	Date	Amount
4/5/54	Labor	3 45		3-31-54	Deposited 65 00
	10% overhead	35	3 80	5-3-54	Refunded (17 45)
	60' 3/4" copper tubing @ .35	21 00			NON CHARGE 47 55
	1-3/4" Cx 3/4" I.W.B. Stop & waste	4 00		4/5/54	Labor 3 45
	2 hrs. Littlefield shovel @ 7.50	15 00			1-3/4" copper tubing @ .35 3 50
	1 hr. trucking	75			1-3/4" C curb cock 4 33
	patching 3 x 3	3 00			1-3/4 Cx 3/4 C. curb cock 4 67
			47 55		1- Box & rod 3 90
					1- 1/2 offset tail piece 50
					1- 1/2 straight tail piece 50
					1 hr Littlefield shovel 7 50
					1 hr trucking 75
					<u>29 10</u>

TOWN OF LEXINGTON — BOARD OF PUBLIC WORKS

**WATER DIVISION**

Sketch of Service Here

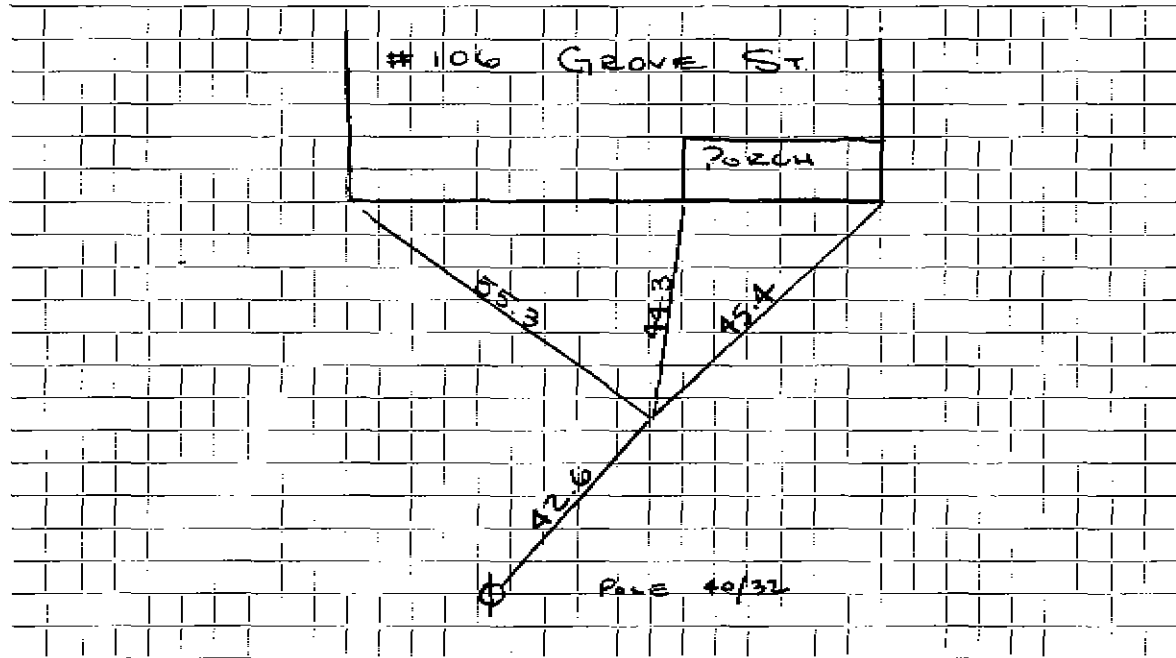

Connection made in ..... Street. Work completed .....

Remarks: .....

.....

.....