




DATE \_\_\_\_\_

TOWN OF LEXINGTON — BOARD OF PUBLIC WORKS  
**WATER DIVISION**

Sketch of Service Here

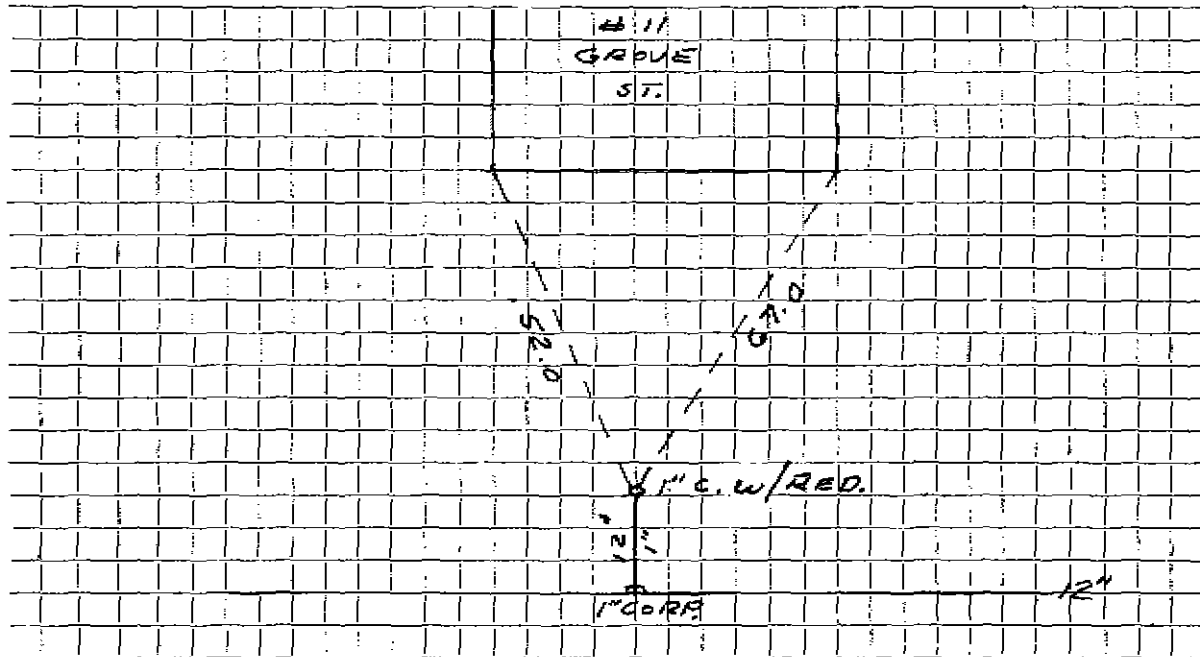

Connection made in GROVE Street. Work completed .....

Remarks: 3/4" INSIDE .....

.....  
.....