

WATER SERVICE RECORD

Name Harold W. Barnard

Service No. 280

816
1013
280
6199

Address 110 Grove Street

Location

~~Repair/Extension~~ - New Service

Com 12-31-54


Date	Material	Amount	Total	Date	Amount
11/24/54	Labor	4.60		11-31-54	Deposited 50.00
	10% overhead	.46	5.06	12-31-54	Refunded 4.19
	60' - 3/4" copper tubing @ .35	21.00			NOV CHARGE 45.81
	1 - 3/4" C x 1/2 I.W.H. stop & waste	4.00		11/24/54	Labor 4.60
	2 hrs. Littlefield shovel @ 7.50	15.00		3' - 3/4" copper tubing @ .35	1.05
	1 hr. trucking	.75		1 - 3/4" C. corp-cock	4.33
			45.81	1 - 3/4" C curb-cock	4.67
				1 box and rod	3.90
				1 - 1/2 offset tail piece	50
				1 - 1/2 straight tail piece	50
				2/3 hr. Littlefield shovel @ 7.50	5.00
				1 hr. trucking	.75
					<u>25.30</u>

DATE _____

TOWN OF LEXINGTON — BOARD OF PUBLIC WORKS

WATER DIVISION

Sketch of Service Here

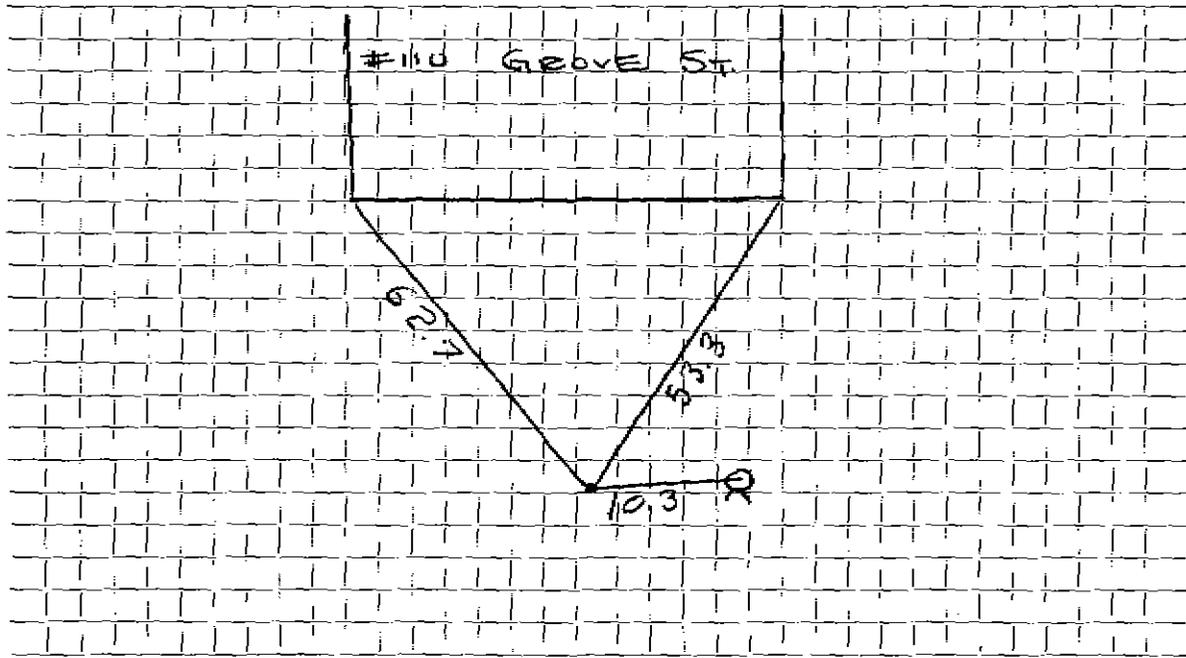

Connection made in Street. Work completed

Remarks:

Handwritten scribbles and marks at the bottom left of the page.