


Date: 8/17/2020

TOWN OF LEXINGTON - BOARD OF PUBLIC WORKS
WATER DIVISION

SKETCH OF SERVICE HERE

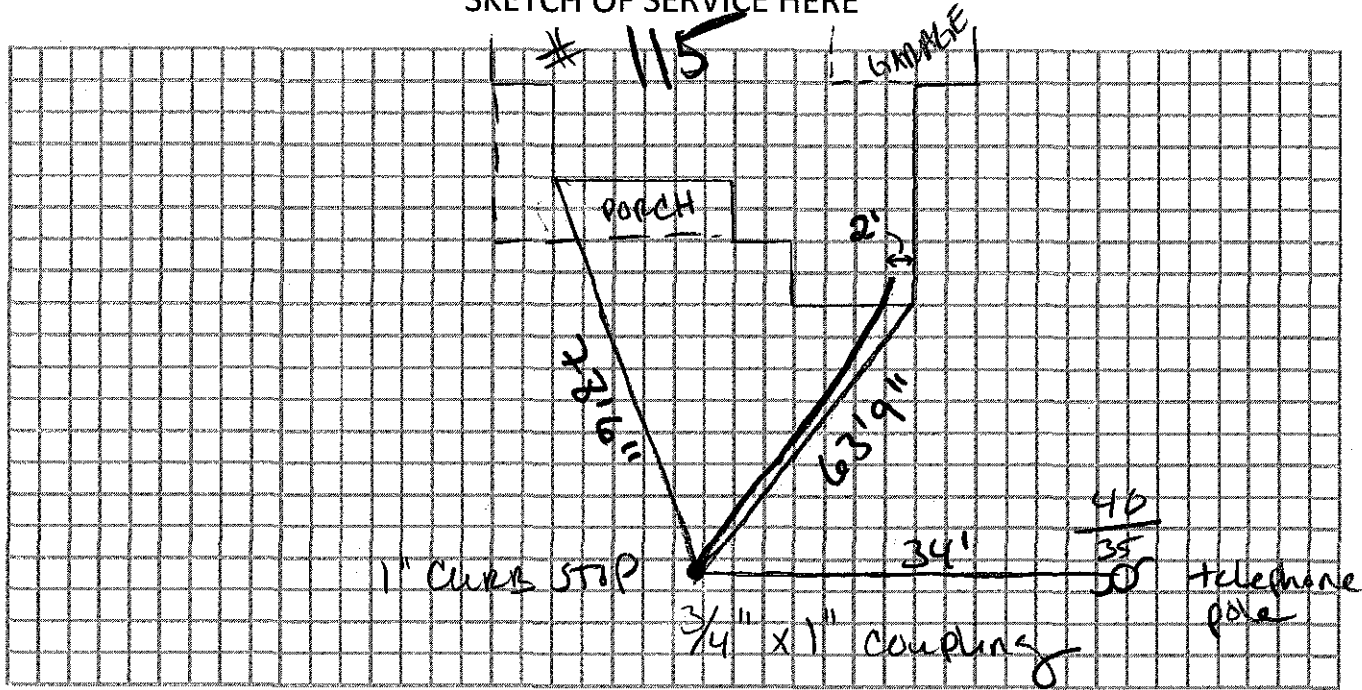

Connection made in: Grive St Street. Work completed:

Remarks: