

WATER SERVICE RECORD

Name Grove Street Elementary School (Day Square Plumbing Co., Inc.)

Service No. 85

Address 117 Grove Street

Location

~~Repair~~ ~~Renewal~~ New Service

Jan 19 24-60

Date	Material	Amount	Total	Date		Amount
6-20-60	Labor	117.38		6-8-60	<i>Deposit</i>	500.00
	10¢ O.S.	11.74	129.12	11-24-60	<i>Check</i>	249.75
1	8" Miller Gate Valve		93.13			250.25
2	hrs. Town Shovel @6.50		13.00		NON CHARGE	
1	hr. Trailer @3.00		3.00	6-17-60	Labor	149.06
4	hrs. Trucking @3.00		12.00	6-18-60	"	170.80
			250.25			319.86
				4	hrs. Allis Chalmers @3.00	12.00
				1	hr. Trailer @3.00	3.00
				8	hr. Trucking @3.00	24.00
				5	hrs. Town Shovel @6.50	32.50
				2	hrs. Trojan Loader @3.00	6.00
						397.36
					<u>(Work on Robinson Road Installing Main)</u>	


DATE _____

TOWN OF LEXINGTON — BOARD OF PUBLIC WORKS

WATER DIVISION

Sketch of Service Here

● 79-5 -TIE

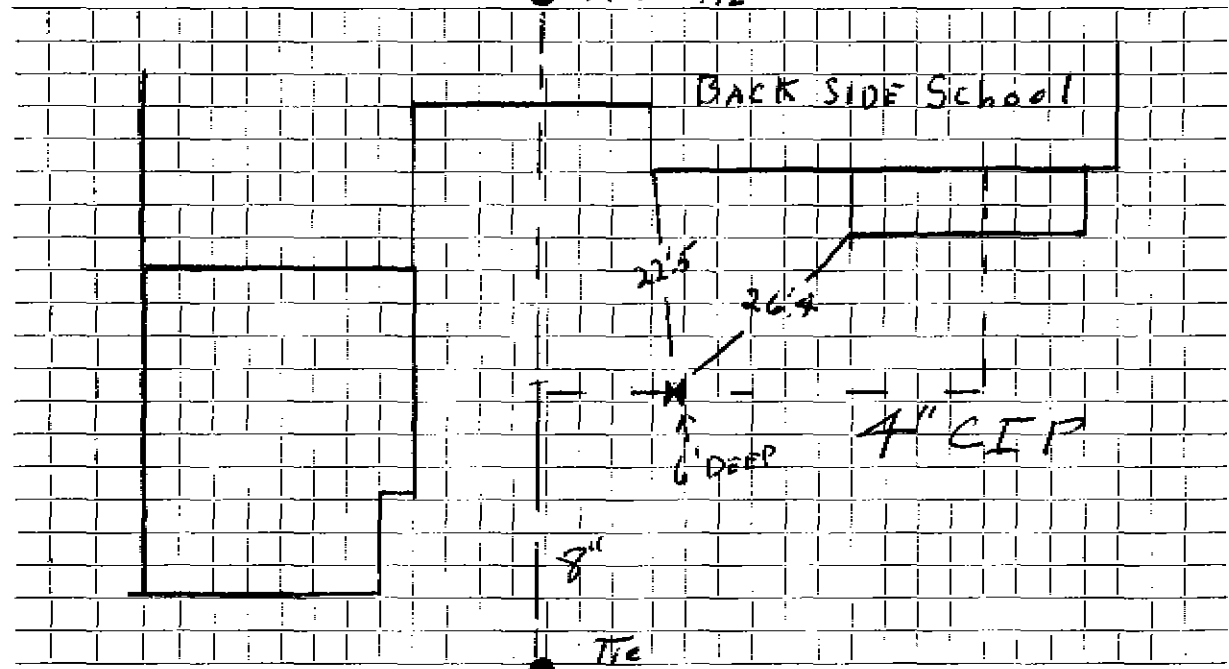

Tie
● 69-5

Connection made in Street Work completed

Remarks: 4" O.D. PIPE CLAMP HAS TO HAVE RANGE 390 - 405 OR CLOSE TO IT

↑