

WATER SERVICE RECORD

#1545

Name Ferbert Rich

Service No. 140

Address 118 Grove Street

Location

~~Regular Meter~~ New Service

Conn. 8-30-54


Date	Material	Amount	Total	Date	Amount
7/2/54	Labor	1 85		6-21-54	Deposited 25.00
	10% overhead	19	2 04	8-30-54	Refunded (50.71)
	50' - 3/4" copper tubing @ .35		17 50		<u>NON CHARGE</u> 24.29
	1 - 3/4" C x 1/2 I.W.H. stop & waste		4 00	7/2/54	Labor 5 05
	1 hr. trucking		75		10' - 3/4" copper tubing @ .35 3 50
			24 29		1 - 3/4" C. corp-cock 4 33
	FRENCH DUG BY OWNER:				1 - 3/4" C. curb-cock 4 67
					1 box and rod 3 90
					1 - 1/2 straight tail piece 50
					1 - 1/2 offset tail piece 50
					2 hrs. Littlefield shovel @ 7.50 -15 00
					1 hr. trucking 75
					<u>38 20</u>

DATE _____

TOWN OF LEXINGTON — BOARD OF PUBLIC WORKS

WATER DIVISION

Sketch of Service Here

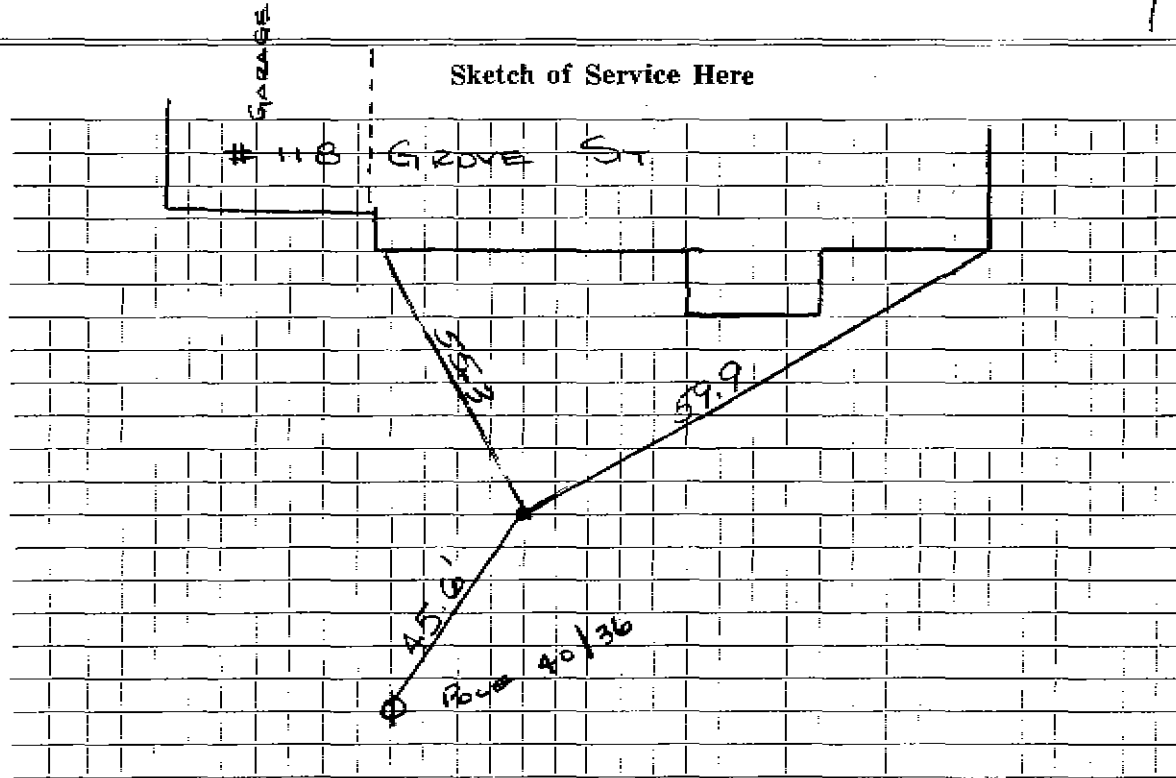

Connection made in Street. Work completed

Remarks:
.....
.....