

Name John J. Smith
Address 121 Grove Street
Lexington, Mass.

Location 121 Grove Street

Kind of Pipe 1" Copper

Size

Size of Main 12"

~~Repair~~ ~~Renewal~~ — New Service

Location

Date	Material	Amount	Total	Date	Amount
Sept. 2, '48	Labor	21 60		Sept 16 '48	Deposited 125 00
22	"	34 27	55 87	Oct 28 '48	Refunded 18 96
	10% Overhead		5 59		Non-Charge 106 04
	120' - 1" Copper Tubing @.31		37 20	Sept. 22, '48	Labor 7 75
	1 - 1" C x 3/4" I.W.H. S&W		3 15	35' - 1" Copper Tubing @.31	10 85
	2 - 1" C x 1" C Union(3pts)		3 48	1 - 1" C Corp-cock	3 96
	Trucking 1 hr. @.75		75	1 - 1" C x 1" C Curb-cock	4 80
			106 04	1 - Box & Rod	3 55
				1 - 3/4" Straight Tail Piece	30
				1 - 3/4" Offset Tail Piece	30
				Littlefield Shovel 3 hrs. @7.00	21 00
				Trucking 1 hr. @.75	75
	Labor				53 26

Com. 10/25/48

Hadley Press, Inc., Lexington

DATE _____

TOWN OF LEXINGTON—BOARD OF PUBLIC WORKS

WATER DIVISION

The undersigned applies for a supply of water at No. _____ St. and hereby agrees to comply with the rules and regulations as now, or at any future time, established by the Board of Selectmen.


Am't. of Estimate \$ _____

Owner _____

Am't. Paid \$ _____

Address _____

Builder _____

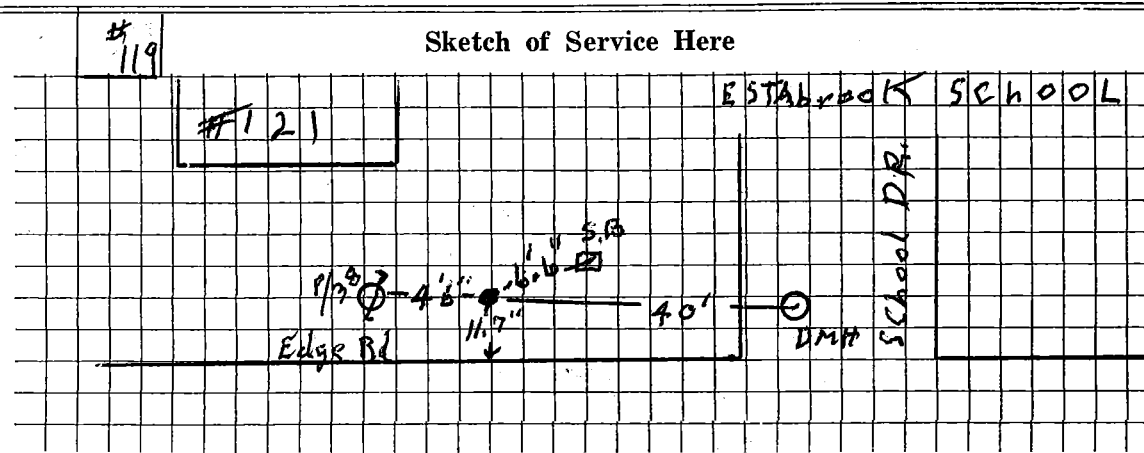

Connection made in Grave St Street.

Work completed _____ 19

Remarks: Service may be for both houses