

WATER SERVICE RECORD

Service No. 164

Name Donald Kourian

Address 124 Grove Street

1977

Location

Reg ~~XXXXXX~~ New Service

Comm. 10-8-56


Date	Material	Amount	Total	Date	Amount
6/23/55	Labor	15 27		6-18-56	Deposit \$ 100 00
	10% Overhead	1 53	16 80	11-2-56	Paid 93
	90' 3/4" Coppertubing @ .4850		43 65		100 93
	1 3/4" Cx 1/2 L.W.H. Stop & Waste		4 96		NON CHARGE
	1 3/4" C Union 3 part		2 27		Labor 3 80
	7 x 3 Patch		7 00		15' 3/4" Coppertubing @ .4850 7 28
	3 hrs. Littlefield @ 8.50		25 50		1 3/4" C. Corp Cpck 4 64
	1 hr. trucking @ .75		75		1 3/4" C Curb " 5 94
			100 93		1 Box & Rod 4 62
					1 1/2 Straight Tail Piece 50
					1 1/2 Offset " " 50
					1 hr trucking 75
					33 69
					Bill sent 10-8-56

TOWN OF LEXINGTON — BOARD OF PUBLIC WORKS

WATER DIVISION

DATE _____

Sketch of Service Here

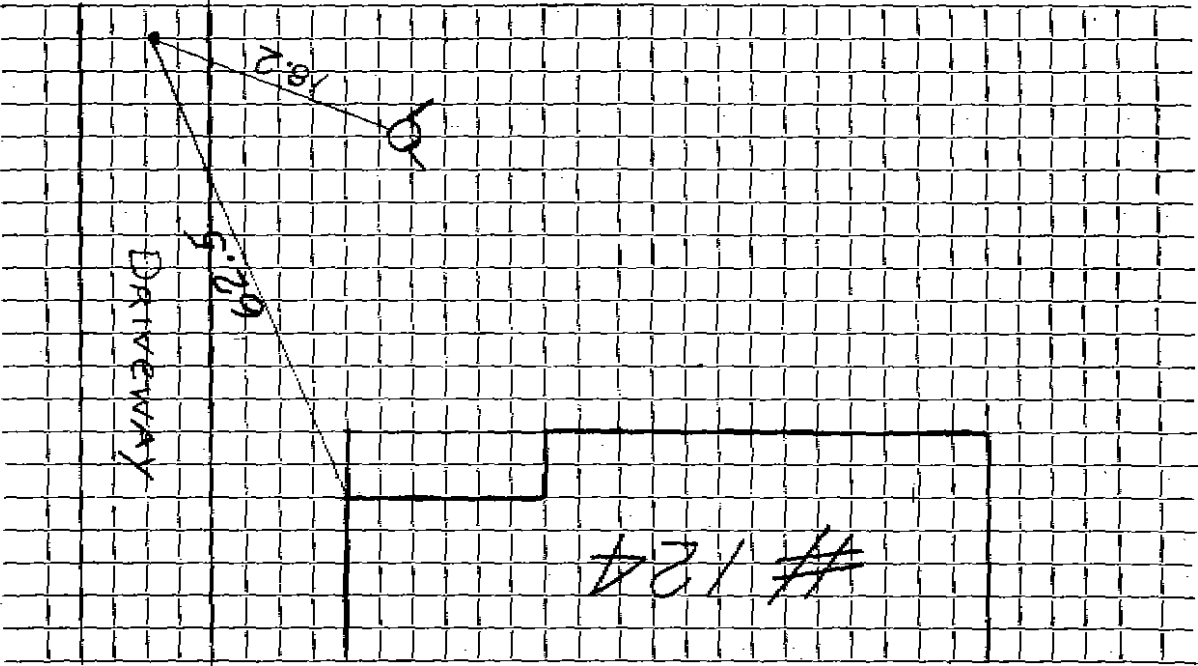

Street. Work completed

Connection made in

Remarks: