

WATER SERVICE RECORD

2135

Service No.

245

Name Robert M. Harvey

Address 129 Grove Street

Location

Repair - ~~BENSON~~ - New Service

*Cam. 10-5-53*


Date	Material	Amount	Total	Date	Amount
9/8/53	Labor	9 50		2-19-53	Deposited 75 00
	10% overhead	95	10 45	4-16-54	Paid ( 9 58
	90' - 3/4" copper tubing @ .3629		32 66		NON CHARGE 64 58
	1 - 3/4" C x 1/2" I.W.H. stop & waste		4 00	9/8/53	Labor 19 67
	1 - 3/4" c x 3/4" C. union		1 72	26'	- 3/4" copper tubing @ .3629 9 44
	2 hrs. Littlefield shovel @ 7.50		15 00	1	- 3/4" C. corp-cock 4 33
	1 hr. trucking		75	1	- 3/4" C x 3/4" C. curb-cock 4 67
	patching 20 x 3		20 00		1 box and rod 3 90
			84 58		1 - 1/2 offset tail pc. 50
					1 - 1/2 straight tail pc. 50
					2 hrs. Littlefield shovel @ 7.50 15 00
					1 hr. trucking 75
					58 76
<i>bill sent 10-2-53</i>					

DATE \_\_\_\_\_

TOWN OF LEXINGTON — BOARD OF PUBLIC WORKS

**WATER DIVISION**

Sketch of Service Here

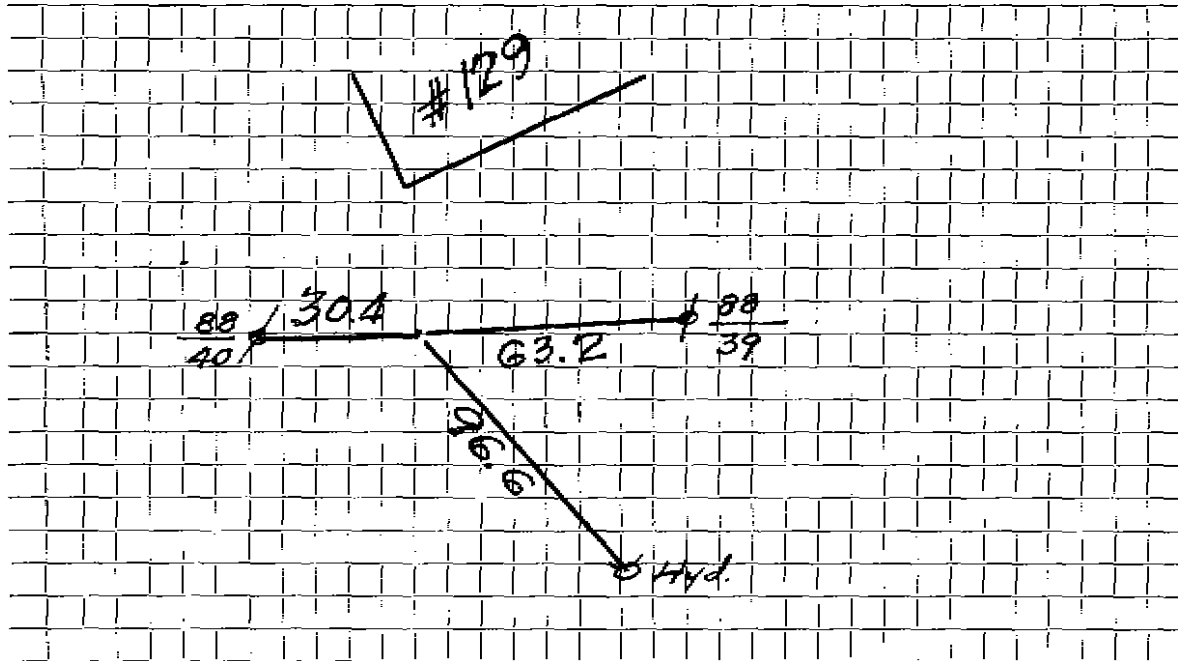

Connection made in \_\_\_\_\_ Street. Work completed \_\_\_\_\_

Remarks: \_\_\_\_\_

\_\_\_\_\_

\_\_\_\_\_