
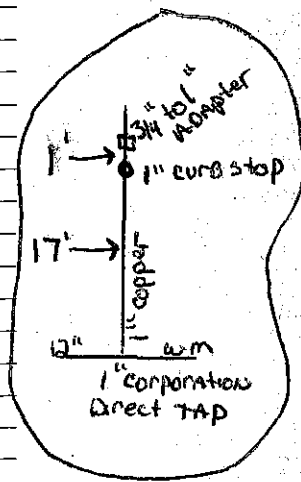


DATE 9-10-20

TOWN OF LEXINGTON — BOARD OF PUBLIC WORKS

WATER DIVISION

Sketch of Service Here

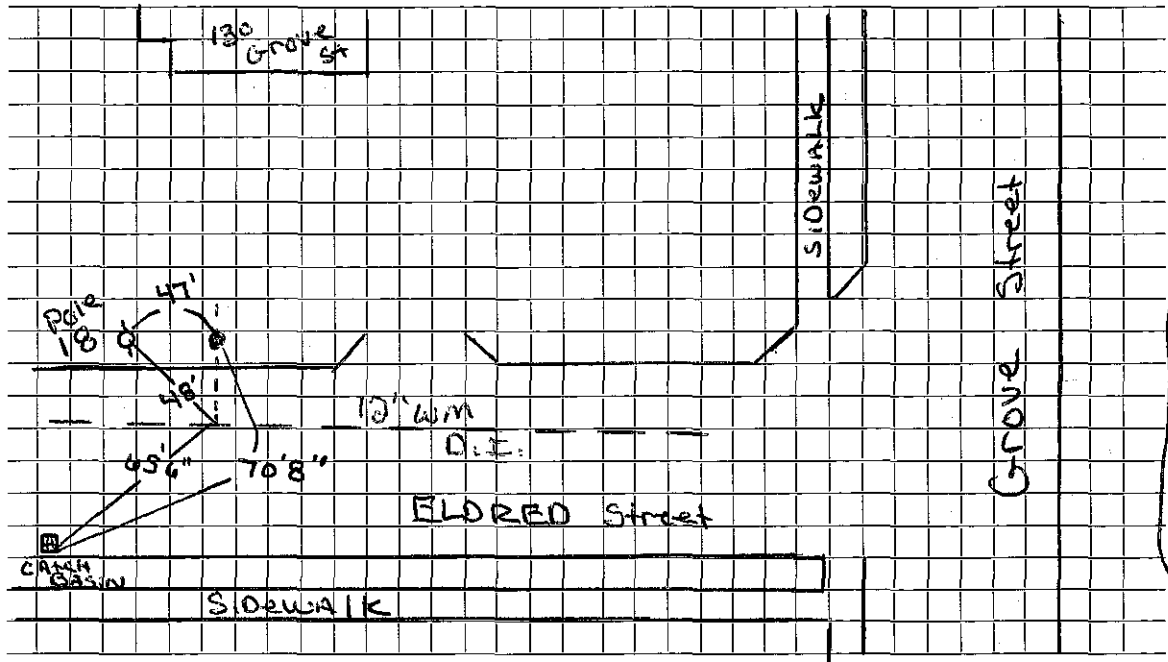

Connection made in Street. Work completed & installed new main to curb stop.

Remarks: CURB Stop is in the woods off of ELDRED street