




DATE 10-21-94

TOWN OF LEXINGTON — BOARD OF PUBLIC WORKS  
WATER DIVISION

Sketch of Service Here

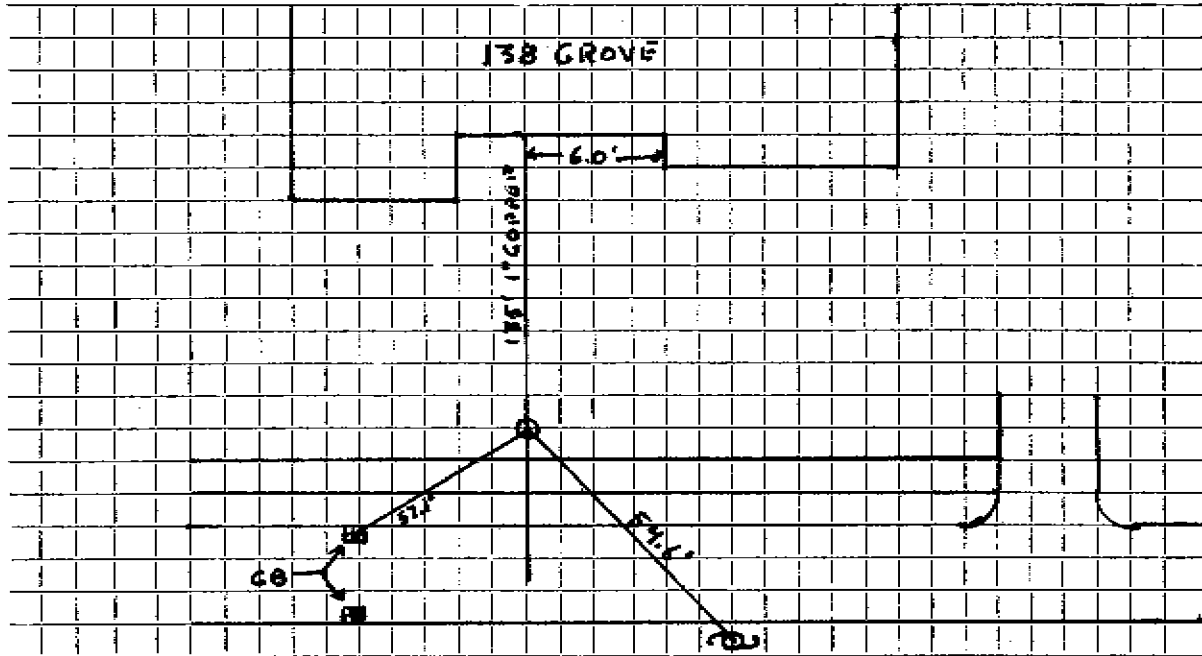

Connection made in Grove Street. Work completed

Remarks: