

WATER SERVICE RECORD

Name Ostlund & Bergquist

Service No. 204

Address 139 Grove Street

Location 139 Grove

Repair, Renewal ~~XXXXXXXXXX~~ New Service WO#7000

Comm 2-26-62


| Date     | Material                        | Amount | Total | Date     | Amount                        |
|----------|---------------------------------|--------|-------|----------|-------------------------------|
| 12/12/61 | Labor                           | 2.04   |       | 12/1/61  | Deposit 100.00                |
|          | 10% O.H.                        | 20     | 2.24  | 2-26-62  | Refund 26.96                  |
|          | 130' 3/4" Copper tubing @.42    |        | 54.60 |          | 13.04                         |
|          | 1 3/4" c x 1/2 IWH Stop & Waste |        | 6.17  |          |                               |
|          | 3 3/4" C3 Part Union @ 2.41     |        | 7.23  |          | CURB TO MAIN                  |
|          | 1 hr. Trucking @ 3.00           |        | 3.00  | 12/12/61 | Labor 1.84                    |
|          |                                 |        | 73.04 | 24'      | 3/4" Copper tubing @.42 10.08 |
|          | REPAIR                          |        |       | 1        | 3/4" C Corp Cock 4.91         |
| 11/1/90  | 1 3/4" Comp. Curb Stop          |        |       | 1        | 3/4" C Curb Cock 6.28         |
|          |                                 |        |       | 1        | Box & Rod 4.90                |
|          |                                 |        |       | 1        | 1/2 Straight Tailpiece .50    |
|          |                                 |        |       | 1        | 1/2 Offset Tailpiece .50      |
|          |                                 |        |       |          | 29.01                         |

DATE \_\_\_\_\_

TOWN OF LEXINGTON — BOARD OF PUBLIC WORKS

WATER DIVISION

Sketch of Service Here

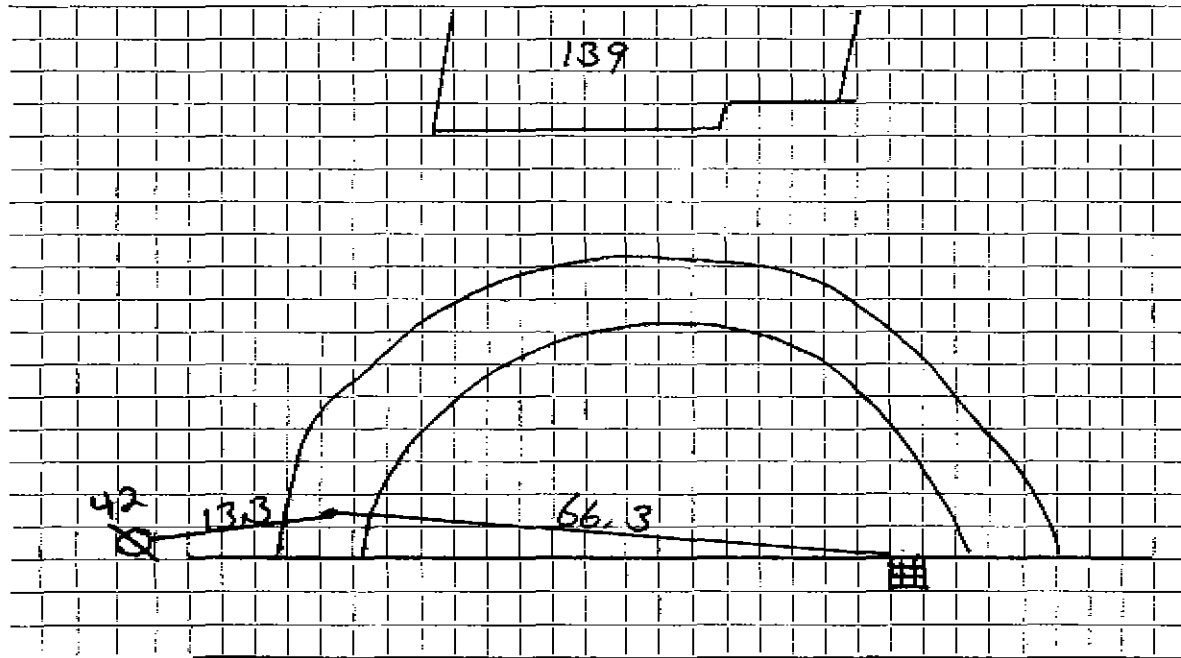

Connection made in ..... Street. Work completed .....

Remarks: .....

.....

.....