

WATER SERVICE RECORD

#2014

Name Oscar W. Carlson

Service No. 3

Address 140 Grove Street

Location

~~Report Renewal~~ - New Service

Committed 4-2-56


Date	Material	Amount	Total	Date	Amount
1-12/56	Labor	20 20		1-12-56	Deposited \$ 25 00
	10% overhead	2 02	22 22	4-10-56	Paid 15 93
	50' - 3/4" Copper tubing @ .50	25 00	25 00		NON CHARGE 90 93
	1 - 3/4" Cx 1/2 I.W.H. Stop & Waste	4 96	4 96	1/17/56	Labor 13 30
	4 hrs. Littlefield Shovel @ 8.50	34 00	34 00	8' - 3/4" Copper tubing @ .50	4 00
	1 hr. trucking		75	1 - 3/4" Corp Cock	4 34
	4x3 patching		4 00	1 - 3/4" Curb Cock	5 94
			90 93	1 Box & rod	4 62
				1 - 1/2 straight tailpiece	50
				1 - 1 offset tailpiece	50
				1 hr. trucking	75
				2 hrs. Littlefield Shovel @ 8.50	17 00
					50 95
				Bill sent 4-3-56	

DATE _____

TOWN OF LEXINGTON — BOARD OF PUBLIC WORKS

WATER DIVISION

Sketch of Service Here

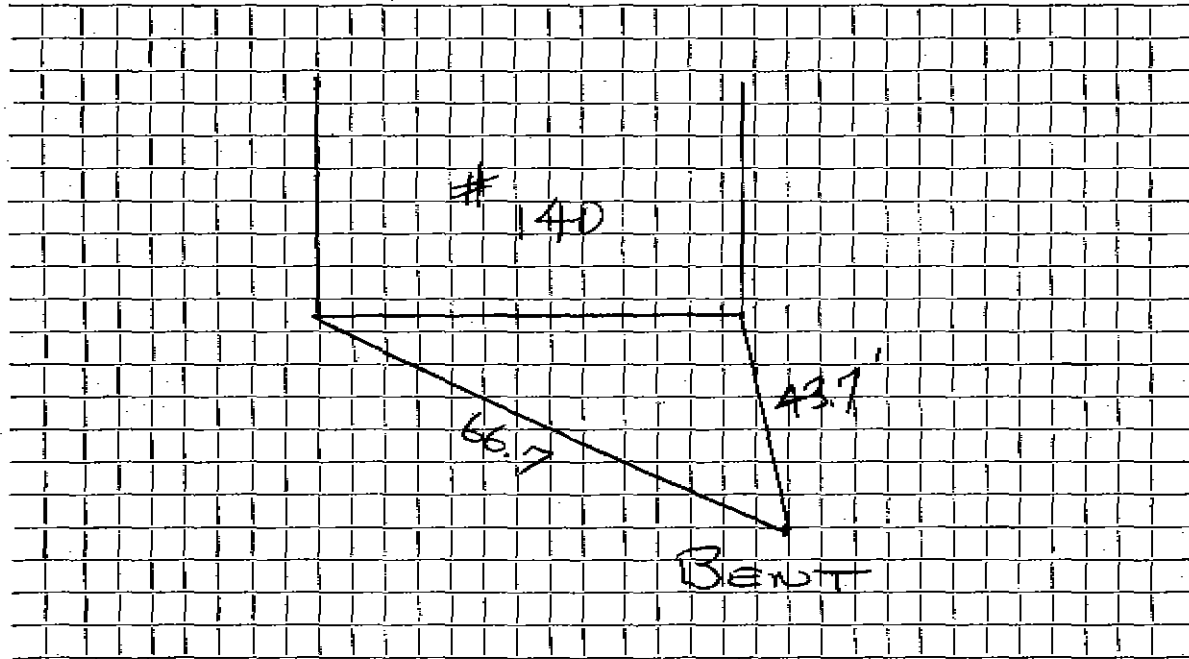

Connection made in Street. Work completed

Remarks:

.....
.....