

WATER SERVICE RECORD

Name Kenneth Walker

Service No. 356

Address 114 Grove Street

Location

~~Repair/Retval~~ - New Service *Cont. 12-31-55*


Date	Material	Amount	Total	Date	Amount
12/5/55	Labor	27 34		11-11-55	Deposited # 100 00
	10% overhead	2 73	30 07	12-31-55	Refunded (12 70)
	50' 3/4" copper tubing @ .56	28 00	58 07		NON CHARGE 87 30
	1 - 3/4 Cx 1/2 I.W.F. Stop & Waste		4 00		Labor 3 70
	3 x 3 patching		3 00		10' 3/4" copper tubing @ .56 5 60
	2 hrs. Littlefield Shovel @ 8.50	17 00	75 07		1 - 3/4 C. Corp Cock 4 33
	1 hr. trucking		75		1 - 3/4 C. Curb Cock 4 67
			87 30		1 box & rod 3 90
					1 - 1/2" straight tail piece 50
					1 - 1/2" offset tail piece 50
					1 hr. Littlefield Shovel 8 50
					<u>31 70</u>

TOWN OF LEXINGTON — BOARD OF PUBLIC WORKS

WATER DIVISION

DATE _____

Sketch of Service Here

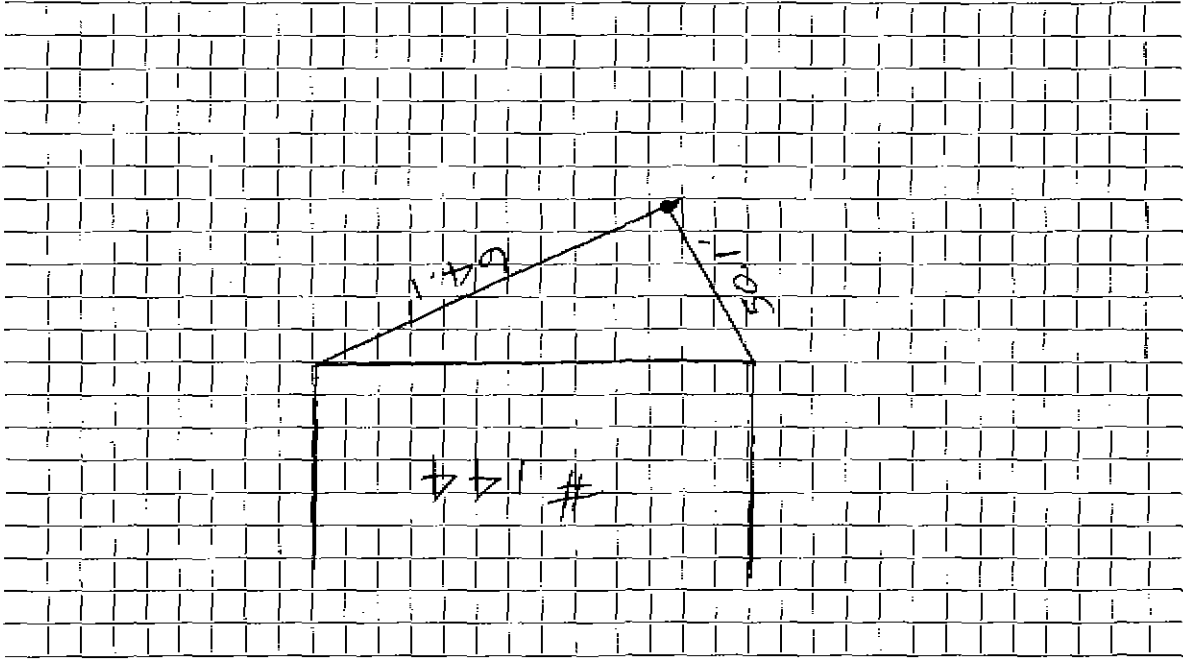

Street. Work completed

Connection made in

Remarks: