

## WATER SERVICE RECORD

Name Leonard Colwell

Service No. 92

Address 145 Grove Street

# 3498

Location

~~XXXXXXXXXX~~ New Service


Comm 8-1-60

Date	Material	Amount	Total	Date	Amount	
6-17-60	Labor	12 42		8-10-60	Deposit	125 00
	10% O.H.	1 24	13 66	8-1-60	Retard	53 01
	48' 3/4" Copper tubing @42		20 16			71 99
	1 3/4" Cx 1/2 I.H.H. Stop & Waste		6 17			
	2 Hrs. Trucking @3.00		6 00		NON CHARGE	
	26 x 3 Patch		26 00	35' 3/4" Copper tubing @42		14 70
			71 99	Labor		24 38
				1 3/4" C Corp Cock		4 91
				1 3/4" C Curb Cock		6 17
				1 Box & Rod		5 00
				1 1/2 Straight tailpiece		50
				1 1/2 Offset tailpiece		50
				3 Hrs. pippin shovel @4.50		13 50
						69 66

DATE \_\_\_\_\_

TOWN OF LEXINGTON — BOARD OF PUBLIC WORKS  
WATER DIVISION

Sketch of Service Here

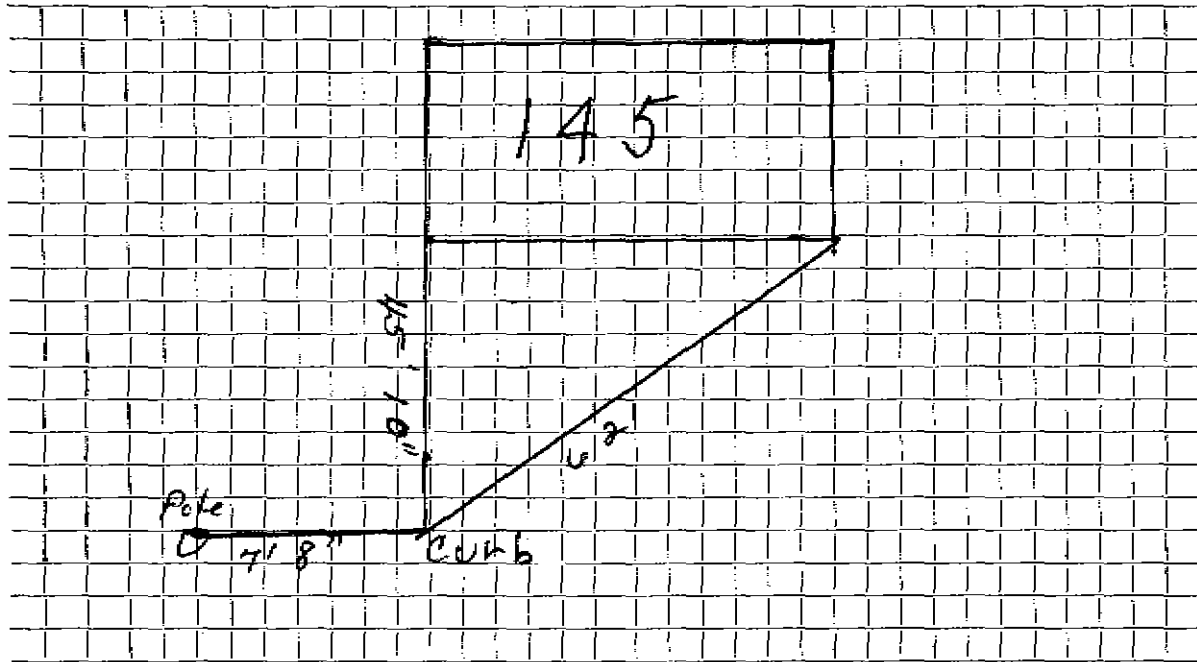

Connection made in ..... Street. Work completed .....

Remarks: .....

.....

.....