

WATER SERVICE RECORD

Name Donald Irwin

Service No. 168

Address 146 Grove Street

Location

560 - # 561

Repair Renewal New Service

Com. 8-30-54


Date	Material	Amount	Total	Date	Material	Amount
7/23/54	Labor	6 65		7-16-54	<i>Deposited</i>	50 00
	10% Overhead	67	7 32	8-30-54	<i>Refunded</i>	(6 13)
	48' - 3/4" Copper tubing @.35		16 80		NON CHARGE	43 87
	1-3/4" C. x 1/2" L.W.F. stop & waste		4 00	7/23/54	Labor	6 65
	2 Hrs. Littlefield Shovel 7.50		15 00	7'-3/4" Copper Tubing @.35		2 45
	1 hr. Trucking		75	1-3/4" C. Corp. Gack		4 33
			43 87	1-3/4" C. x 3/4" C. Gurb-cock		4 67
				1 Box end Rod		3 90
				1-1/2" Straight Tail Piece		50
				1-3/8" Offset Tail Piece		50
				1 hr. Trucking		75
						23 75

DATE _____

TOWN OF LEXINGTON — BOARD OF PUBLIC WORKS

WATER DIVISION

Sketch of Service Here

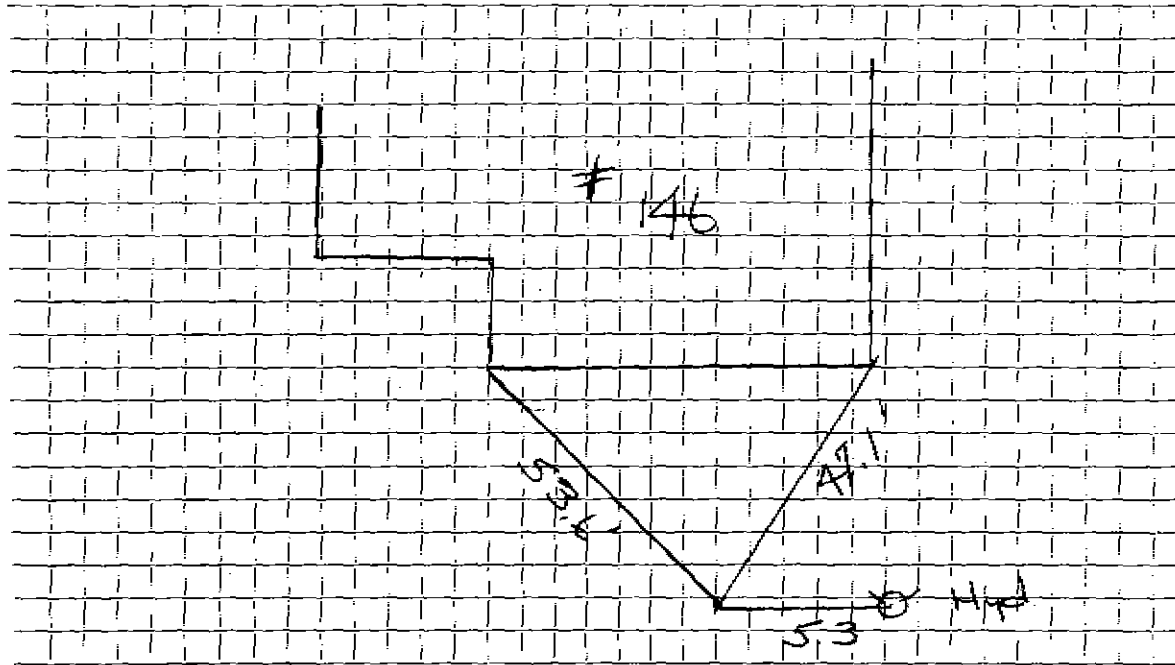

Connection made in _____ Street. Work completed _____

Remarks: _____

