

WATER SERVICE RECORD

Name **William L. Potter**

Service No. **170**

Address # **150 GROVE ST.**

Location

Repair—Renewal—New Service

*W 0 # 6917*

*Comm 2-26-62*


Date	Material	Amount	Total	Date	Amount
12/1/61	Labor	1 84		10-30-61	50 00
	10% O.H.	18	2 02	2-26-62	18 71
55'	3/4" Copper Tubing @ .42		23 10	<i>Retrad</i>	
1	3/4" Cor <sup>1</sup> / <sub>2</sub> IWH STOP & WASTE		6 17		
			31 29		
Curb to Main					
				12/1/61	Labor
					5' 3/4" Copper Tubing @ .42
					1 3/4" C Corp Cook
					1 3/4" C Curb Cook
					1 Box & Rod
					1 1/2 Straight Tailpiece
					1 1/2 Offset Tailpiece
					20 96
<i>* Applied to SHC # 154</i>					

DATE \_\_\_\_\_

TOWN OF LEXINGTON — BOARD OF PUBLIC WORKS

WATER DIVISION

Sketch of Service Here

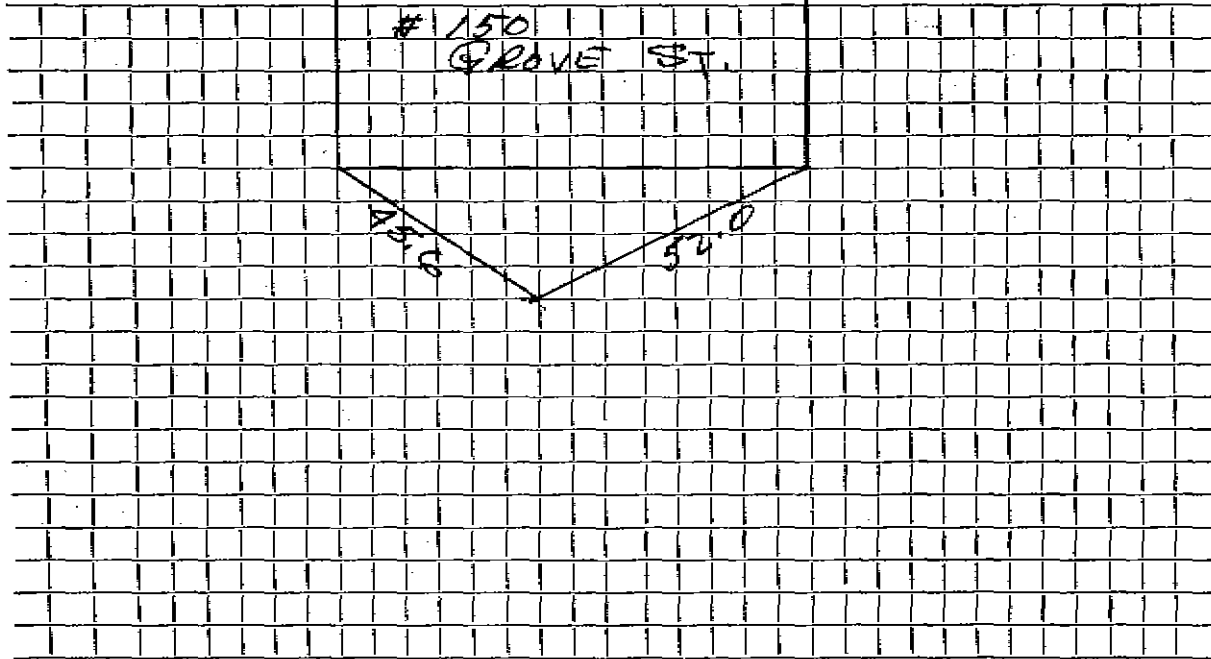

Connection made in ..... Street. Work completed .....

Remarks: .....  
.....  
.....