

DATE


1/8/2019

TOWN OF LEXINGTON — BOARD OF PUBLIC WORKS

WATER DIVISION

Sketch of Service Here

#157

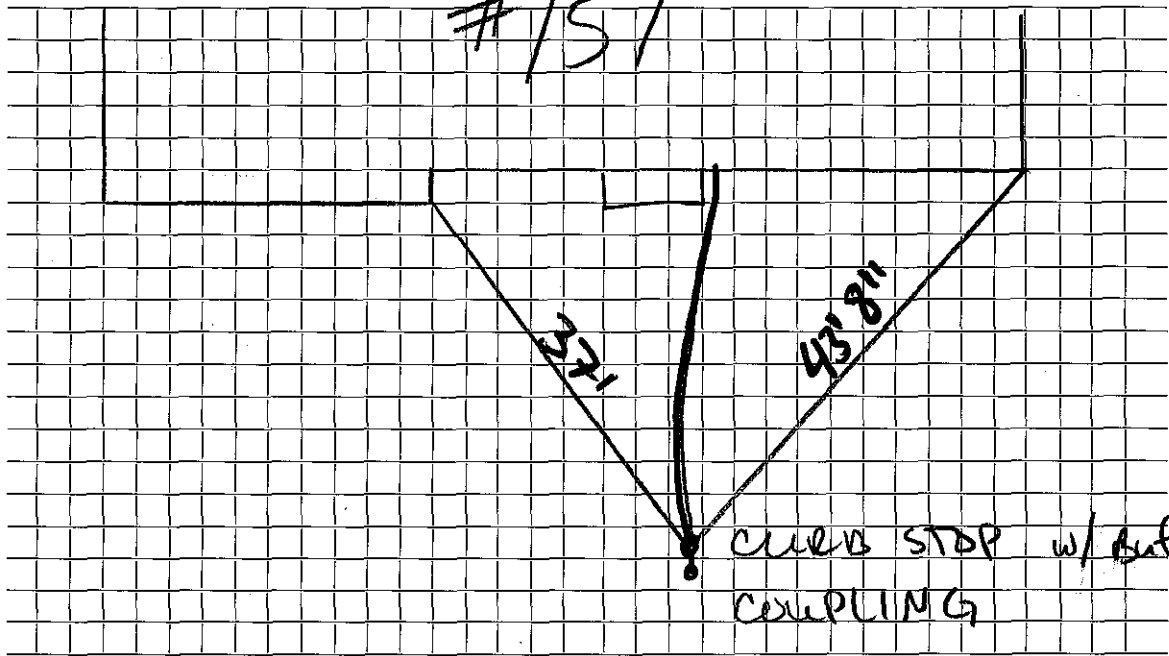

Connection made in ... Grove ... Street. Work completed

Remarks:
.....
.....