

WATER SERVICE RECORD

Name Soule Bros. Inc.

Service No. 132

Address 153 Grove Street

Location (640 Lowell St.,)

~~Repair/ Renewal~~ - New Service

Comm. 12-4-61


Date	Material	Amount	Total	Date	Amount
10/7/61	Labor	4 08		9-19-61	50 00
	10% O.H.	41	4 49	12-4-61	14 25
54	3/4" Copper Tubing @ .42		22 68		35 25
1	3/4" Cx 1/2 IWH Stop & Waste		6 17	10/7/61	3 38
1	3/4" C3 Part Union		2 41		
			35 75		
				35	3/4" Copper tubing @.42 14 70
				1	3/4" C Corp Cock 4 91
				1	3/4" C Curb Cock 6 28
				1	Bow & Rod 4 90
					34 17

DATE _____

TOWN OF LEXINGTON — BOARD OF PUBLIC WORKS

WATER DIVISION

Sketch of Service Here

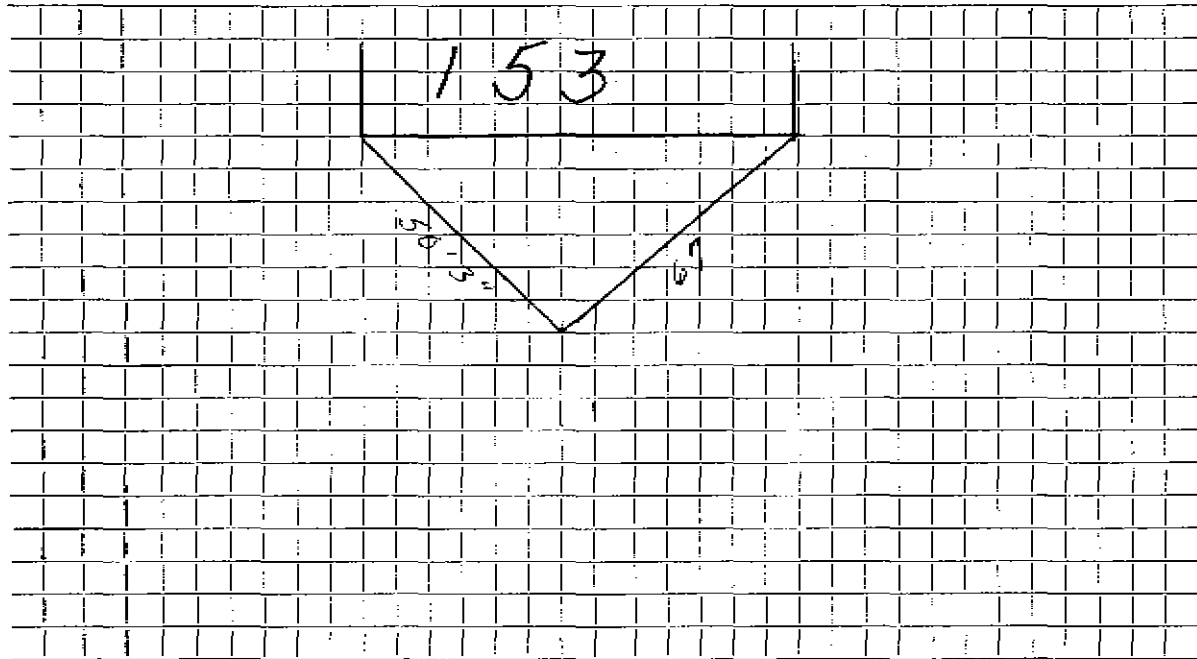

Connection made in Street. Work completed

Remarks:

.....

.....