

## WATER SERVICE RECORD

# 6519

Name Robert Wilson

Service No. 170

Address 162 Grove Street

Location

Repair ~~Renewal~~ New Service

Comm. 10-8-56


Date	Material	Amount	Total	Date	Amount
7/24/56/	Labor	9 70		6-20-56	Deposit \$ 100 00
	10% Overhead	97	10 67	10-8-56	Refund 44 72
	51' 3/4" Coppertubing @.4850		24 74		55 28
	1 3/4 Cx 1/2 I.W.H. Stop & Waste		4 96		
	1 2/3 hrs. Littlefield @.50		14 16		
	1 hr. trucking @.75		75		NON CHARGE
			55 28		
					Labor 3 80
					9' 3/4" Coppertubing @.4850 4 37
					1 3/4 C. Corp Cock 4 64
					1 3/4 C. Curb Cock 5 94
					1 box & rdd 4 62
					1 1/2 Straight bail piece 50
					1 1/2 Offset " " 50
					1/3 hr. Littlefield 2 83
					27 20

DATE \_\_\_\_\_

TOWN OF LEXINGTON — BOARD OF PUBLIC WORKS

**WATER DIVISION**

Sketch of Service Here

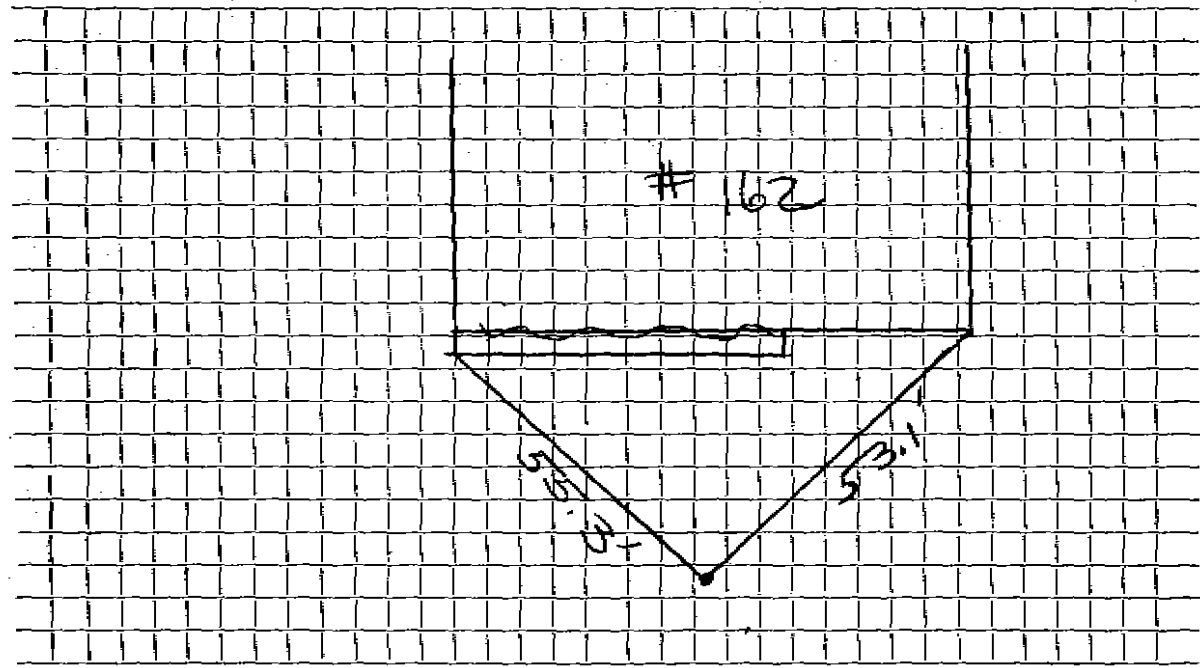

Connection made in ..... Street. Work completed .....

Remarks: .....  
.....