

WATER SERVICE RECORD

Name Leonard Realty Trust

Service No. 311

Address 166 Grove Street

# 2212

Location

~~Repair~~ ~~Renewal~~ ~~Water~~ New Service *Com. 12-19-55*


Date	Material	Amount	Total	Date	Amount
10/10/55	Labor	33 90		9-16-55 Deposited	100 00
	10% overhead	3 39	37 29	12-31-53 Paid	16 92
	70' - 3/4" copper tubing@.56	39 20		<u>NON CHARGE</u>	116 92
	1 - 3/4" C x 3/8" I.W.H. stop& waste	4 00	10/10/55	Labor	3 70
	4 hrs. Littlefield shovel@8.50	34 00	10'	- 3/4" copper tubing@.56	5 60
	1 hr. trucking	75	1	- 3/4" C. corp-cock	4 33
	1 - 3/4" Union	1 72	1	- 3/4" curb-cock	4 67
		116 92	1	box and rod	3 90
				1 - 1/2" straight tail pc.	50
				1 - 1/2" offset tail pc.	50
				1 1/3 hr. Littlefield shovel@3.50	11 33
				1 hr. trucking	75
					<u>35 28</u>
				<del>Bill sent 12-27-55</del>	

DATE \_\_\_\_\_

TOWN OF LEXINGTON — BOARD OF PUBLIC WORKS

**WATER DIVISION**

Sketch of Service Here

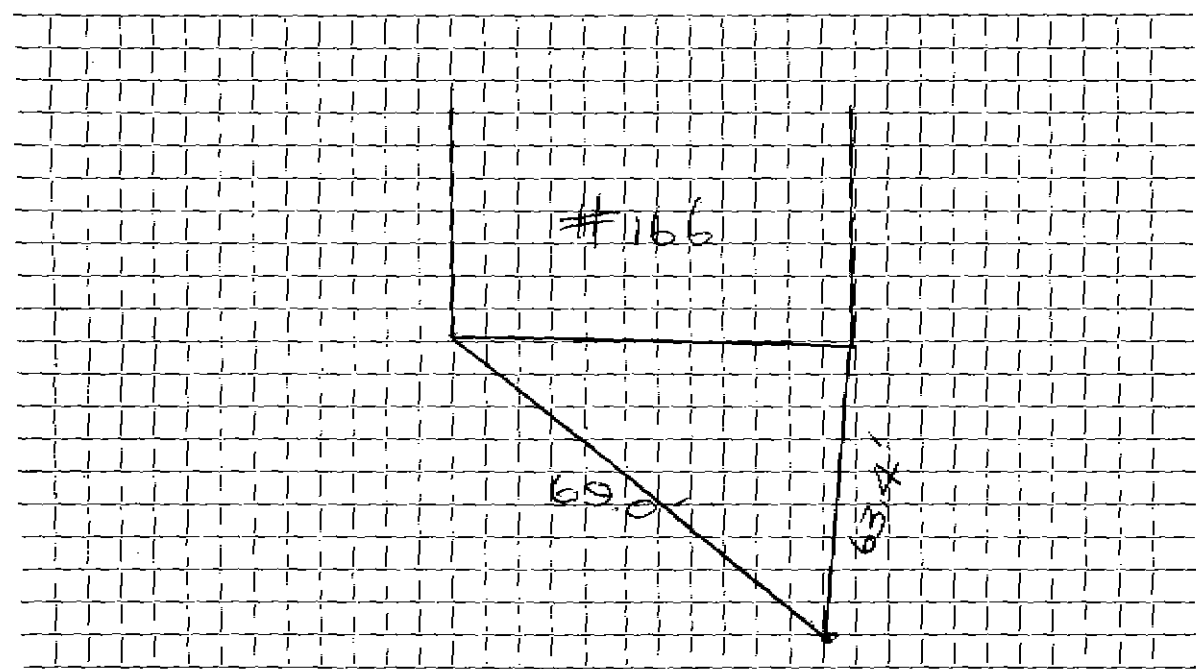

Connection made in ..... Street. Work completed .....

Remarks: .....  
.....  
.....