

WATER SERVICE RECORD

Name Haakon L. Nielson

Service No. 58 (n.d.)

Address 170 Grove Street

Location

~~Repair~~ ~~Renewal~~ New Service

Com. 3-21-55

Date	Material	Amount	Total	Date	Amount
2/29/55	Labor	5 55			
	10% overhead	56	6 11	5-19-55	48 03
	67' - 3/4" copper tubing @ .35		23 45		NON CHARGE
	1 - 3/4" C x 1/2" I.W.H. stop & waste		4 00	2/29/55	labor
	1 - 3/4" C x 1/4" C Union		1 75		15' - 3/4" copper tubing @ .35
	1 hr. trucking				4 33
	patching 12x3		12 00		1 - 3/4" C. corp-cock
			48 03		1 - 3/4" C. curb-cock
	TRENCH DUG BY OWNER				1 box and rod
					1 - 1/2" offset tail piece
					1 - 1/2" straight tail pc.
					4 2/3 hrs. Littlefield shovel @ 7.50
					35 00
					1 hr. trucking
					75
					72 92


Tray Deposit Paid

Bill sent 3-21-55

DATE _____

TOWN OF LEXINGTON — BOARD OF PUBLIC WORKS
WATER DIVISION

Sketch of Service Here

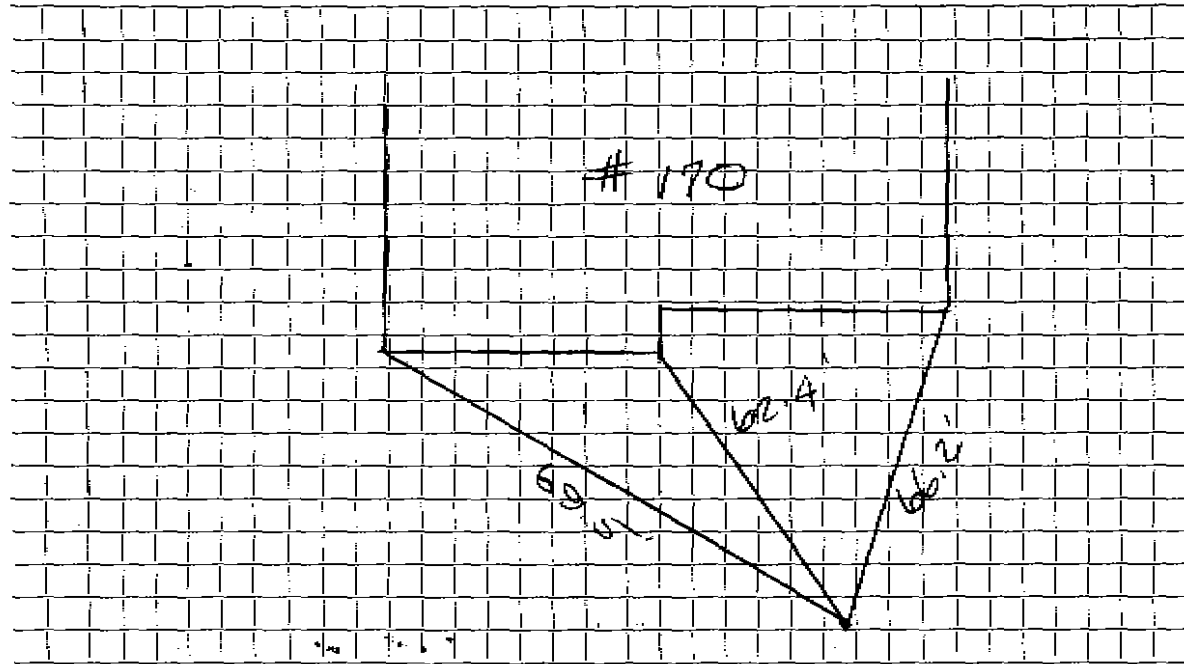

Connection made in Street. Work completed

Remarks:
.....
.....