

# 15-35

WATER SERVICE RECORD

Name Ivar Carlson

Service No. 229

Address 175 Grove St.

Location Lexington

Repair ~~Renewal~~ - New Service

*Com. # 15-53*


Date	Material	Amount	Total	Date	Amount
8/7/53	Labor	21 86		8-3-53	Deposited 115 00
	10% overhead	2 19	24 05	8-3-53	Refunded 8 56
	110'-3/4" Copper Tubing @.3629	39 92	39 92		NON CHARGE 106 44
	1-3/4" C x 1/2" I.W.H. STOP & WASTE	4 00	4 00	8/7/53	Labor 21 88
	1-3/4" C x 3/4" C. Union (3 parts)	1 72	1 72		30'-3/4" Copper Tubing @.3629 10 89
	1 Hr. Littlefield Shovel @7.50	7 50	30 00		1-3/4" C. Corp-cock 4 33
	1 Hr. Trucking	75	75		1-3/4" C. x 3/4" C. Curb-cock 4 67
	Patching 6 x 3	6 00	6 00		1-Box & Rod 3 90
			106 44		1-1/2" offset tail piece 50
					1-1/2" straight tail piece 50
					2 hr. Littlefield Shovel @7.50 15 00
					1 Hr. Trucking 75
					<u>62 42</u>

DATE \_\_\_\_\_

TOWN OF LEXINGTON — BOARD OF PUBLIC WORKS

**WATER DIVISION**

Sketch of Service Here

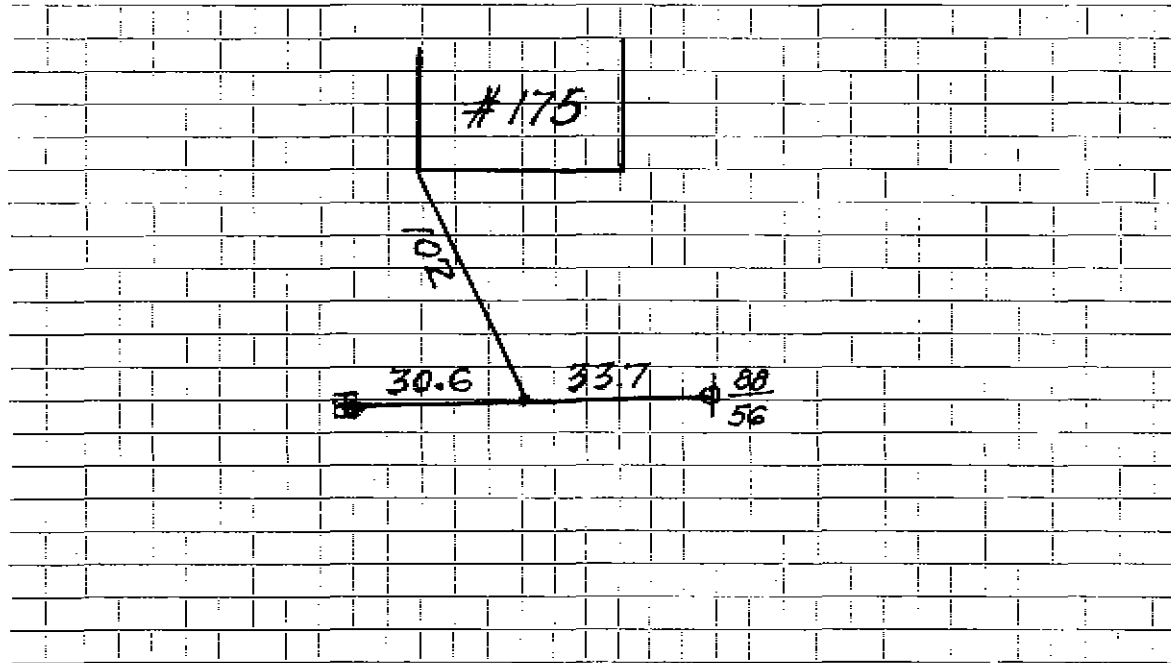

Connection made in ..... Street. Work completed .....

Remarks: .....

.....

.....