

WATER SERVICE RECORD

1450

Name William Smith

Service No. 305 (1954)

Address 176 Grove Street

Location

~~Repair~~ ~~Renewal~~ New Service

*Com. 3-21-55*


Date	Material	Amount	Total	Date	Amount
2/29/55	Labor	5 55		12-15-54	75 00
	10% overhead	56	6 11	3-21-55	(26 97)
	67' - 3/4" copper tubing@.35		23 45		NON CHARGE
	1 - 3/4" C x 1/2 I.W.H. stop& waste		4 00	2/29/55	38 03
	1 - 3/4" C. union		1 72		Labor
	1 hr. trucking		75		14 65
	patching 12 x 3		12 00		15' - 3/4" copper tubing@ .35
			48 03		5 25
	TRENCH DUG BY OWNER:				1 - 3/4" C. corp-cock
					4 33
					1 - 3/4" C. curb-cock
					4 67
					1 box and rod
					3 90
					1 - 1/2 offset tail pc.
					50
					1 - 1/2 straight tail pc.
					50
					4 hrs. Littlefield shovel@ 7.50
					30 00
					1 hr. trucking
					75
					64 55

DATE \_\_\_\_\_

TOWN OF LEXINGTON — BOARD OF PUBLIC WORKS

WATER DIVISION

Sketch of Service Here

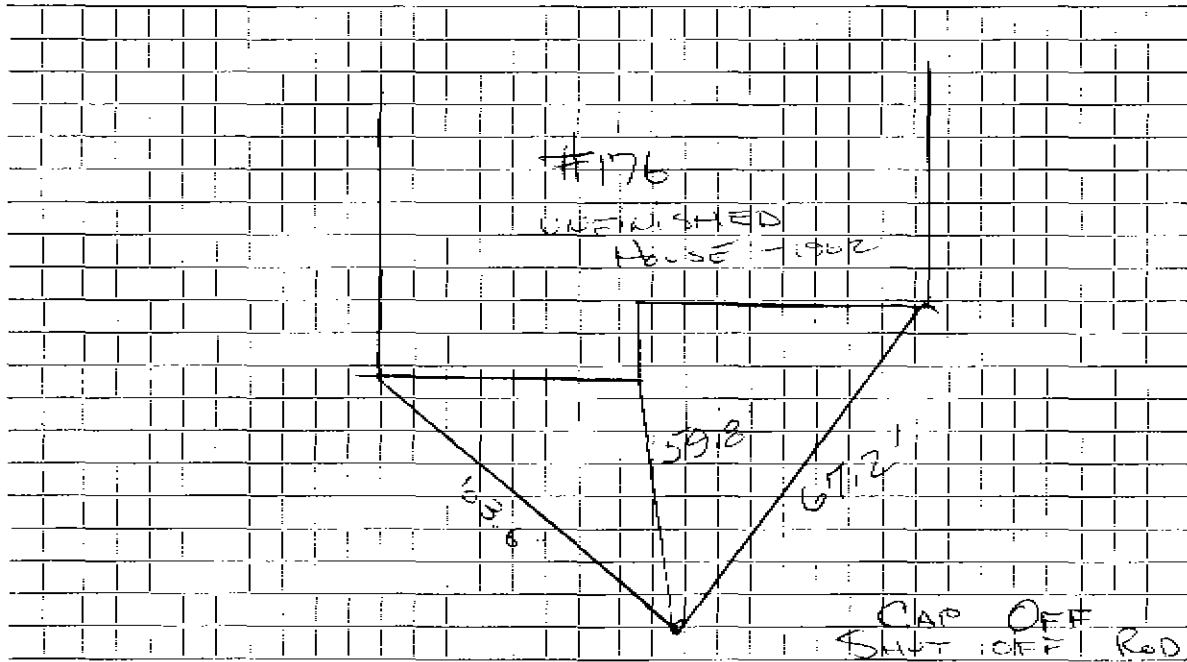

Connection made in ..... Street. Work completed .....

Remarks: .....  
.....  
.....