

#336

WATER SERVICE RECORD

Name

Service No. 57

Address 178 GROVE ST

Location COMPANY WESTER CONSTRUCTION

Repair—Renewal—New Service


Date	Material	Amount	Total	Date	Amount
5-14-03	RENEW INSIDE			4-2-57	DEPOSIT \$100 00
	54-5" 1" COPPER TUBING			6-10-57	REFUND \$28 42
	1 1" x 3/4" COMP ADP				NON CHARGE
	1 6" PICES 3/4" COPPER			4-15-57	LABOR \$25 99
				18' 3/4" COPPER TUBING (A) .4228	\$7 61
				1 3/4" C COMP COCK	\$4 64
				1 3/4" CURB COCK	\$5 94
				1 BOX + ROD	\$4 62
				1 1/2" STRAIGHT TAIL PIECE	50
				1 1/2" OFFSET TAIL PIECE	50
				2 HRS TOWN SHOVEL @ 6.50	13 00
					<u>62 80</u>

DATE \_\_\_\_\_

TOWN OF LEXINGTON — BOARD OF PUBLIC WORKS

WATER DIVISION

Sketch of Service Here

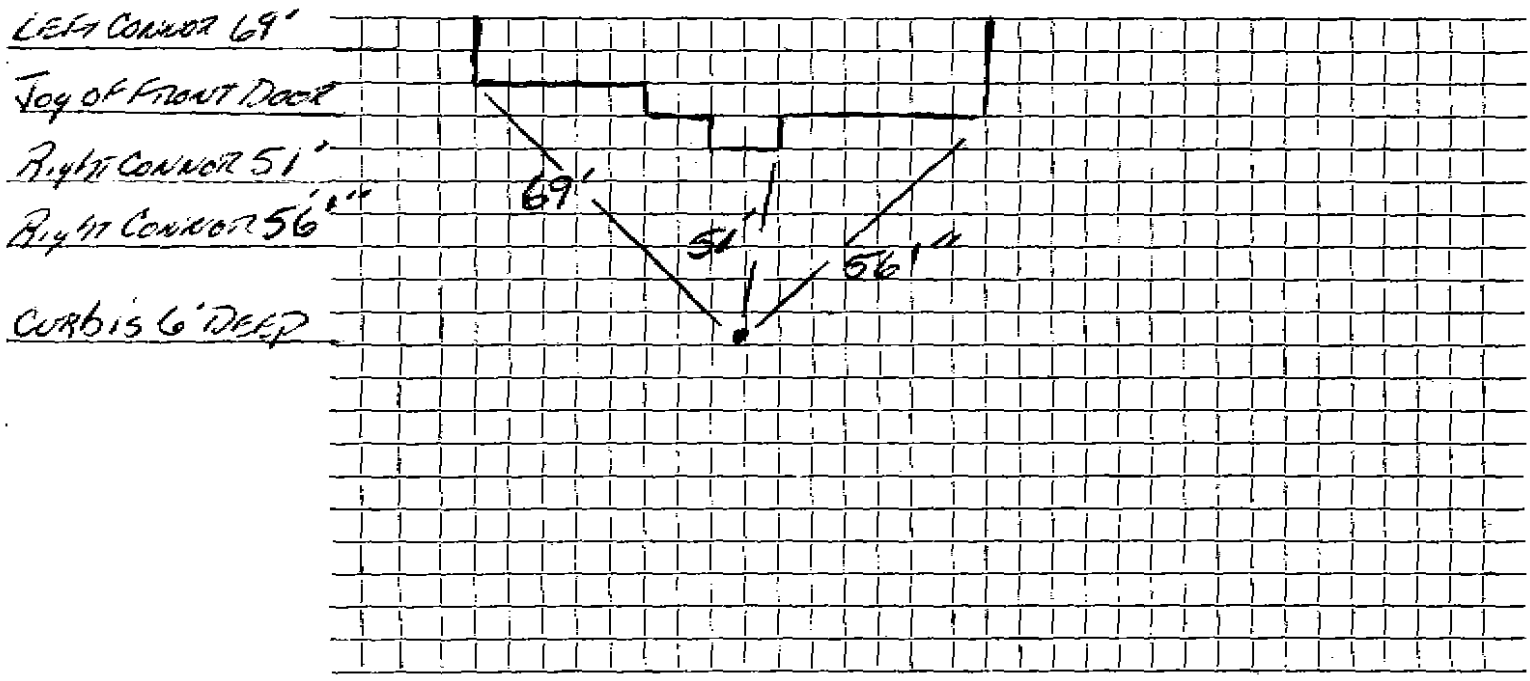

Connection made in ..... Street. Work completed .....

Remarks: .....

.....

.....

WATER SERVICE RECORD

Name Leonard Realty Trust

Service No. 57

Address 178 Grove St. (Mail--144 Page Road, Bedford)

Location

~~Repair/Removal~~ - New Service

Comm. 6-10-57


Date	Material	Amount	Total	Date	Amount
4/12/57	Labor	11 14		4-2-57	Deposit \$100 00
	10% overhead	1 11	12 25	6-10-57	Refund 28 42
	60' 3/4" Copper tubing @.4228		25 37		\$ 71 58
	1 3/4" C x 1/2 I.W.H. Stop & Waste		4 96		NON CHARGE
	2 Hrs. Town Shovel @6.50		13 00	4/15/57	Labor 25 99
	1 hr. trucking		3 00		
	1 Hr. Rodgers Trailer @3.00		3 00		18' 3/4" Copper tubing @.4228 7 61
	10 x 3 Patch		10 00		1 3/4" C Corp Cock 4 64
			71 58		1 3/4" C Curb Cock 5 94
					1 Box & Rod 4 62
					1 1/2 Straight tail piece 50
					1 1/2 Offset tail piece 50
					2 Hrs. Town Shovel @6.50 13 00
					62 80

DATE \_\_\_\_\_

TOWN OF LEXINGTON — BOARD OF PUBLIC WORKS

**WATER DIVISION**

Sketch of Service Here

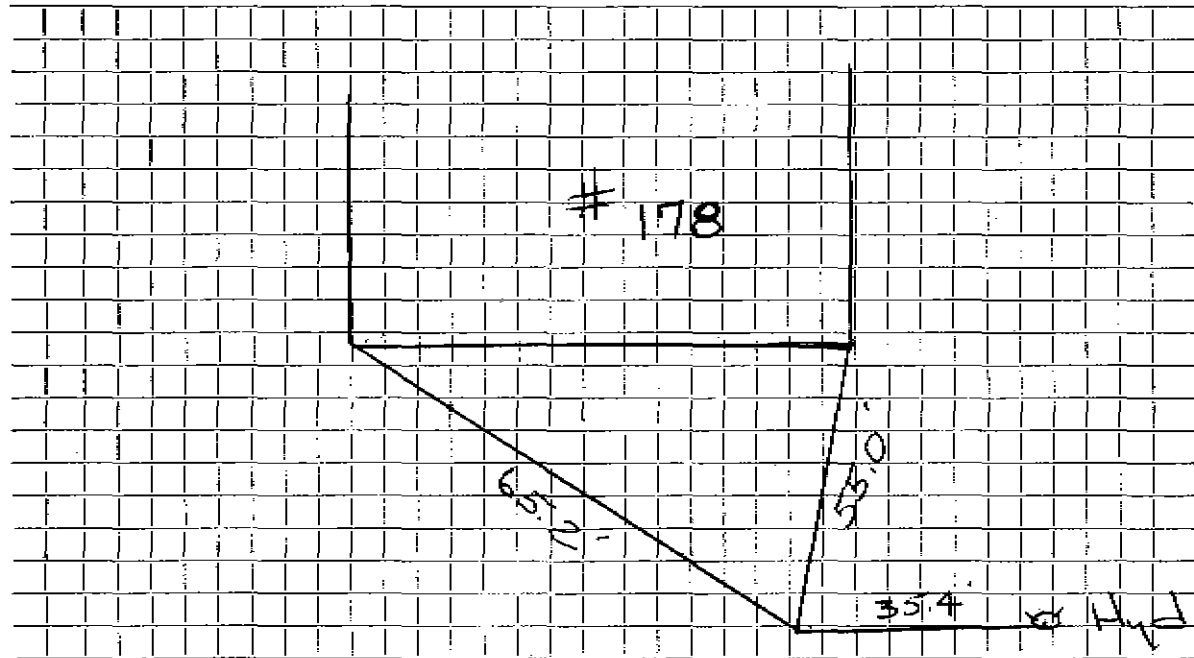

Connection made in ..... Street. Work completed .....

Remarks: .....

.....

.....