

WATER SERVICE RECORD

#1631

Name George Anderson

Service No.

161

Address 179 Grove Street

Location

Repair ~~Renewal~~ - New Service

*Em 7-13-53*


Date	Material	Amount	Total	Date	Amount	
6/19/53	Labor	9 50		6-17-53	Deposited	25 00
	10% overhead	95	10 45	7-13-53	Refunded	2 60
	60' - 3/4" copper tubing@.37		22 20		NON CHARGE	72 40
	1 -3/4" C x 1/2 I.W. stop & waste	4 00	4 00	6/23/53	Labor	13 24
	2 hrs. Littlefield shovel@7.50	15 00	15 00		27' - 3/4" copper tubing@.37	9 99
	1 hr. trucking		75		1 -3/4" C. corp-cock	4 33
	patching 20 x 3		20 00		1 -3/4"C x 3/4"C. curb-cock	4 67
			72 40		1 box and rod	3 90
					1 -1/2 offset tail pc.	50
					1 -1/2 straight tail pc.	50
					2 hrs. Littlefield shovel@7.50	15 00
					1 hr. trucking	75
						52 88

TOWN OF LEXINGTON - BOARD OF PUBLIC WORKS

WATER DIVISION

DATE \_\_\_\_\_

Sketch of Service Here

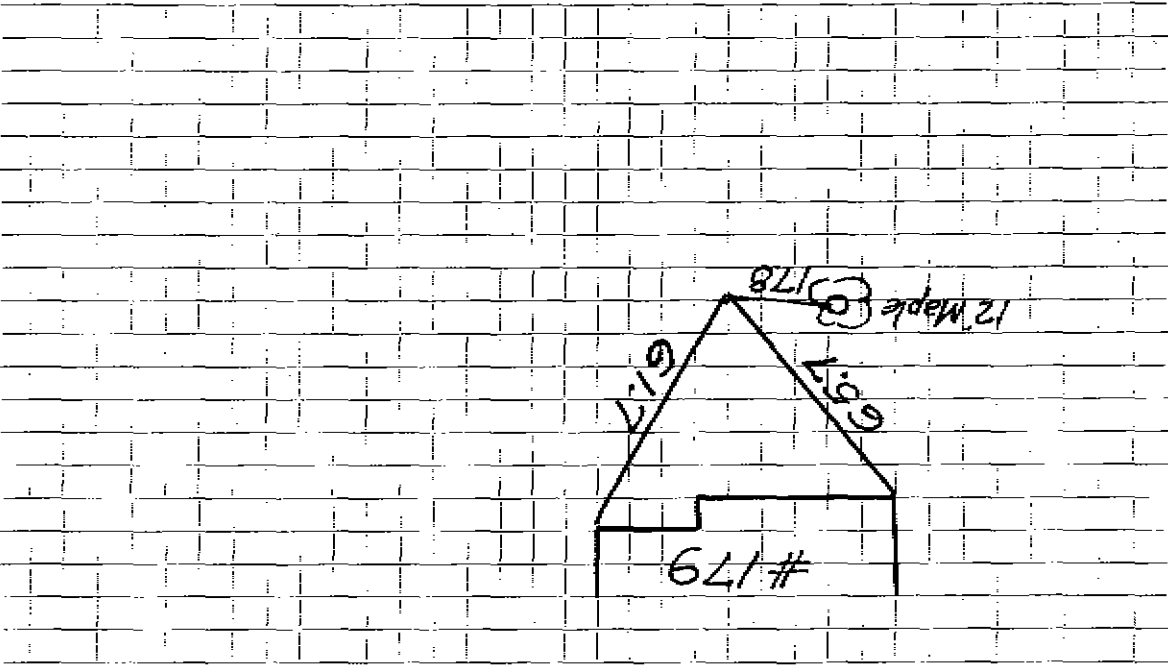

Work completed

Street

Connection made in

Remarks:

78