

WATER SERVICE RECORD

#1 105

Service No. 85

Name John Cantrell

Address 180 Grove St., Lexington

Location Mail:163 Burnham Road, Lowell

Repair ~~XXXXXX~~ - New Service

Com. 11-21-55


Date	Material	Amount	Total	Date	Amount
8/26/55	Labor	5 05		8-16-55	Deposited 100 00
	10% Overhead	51	5 56	11-21-55	Refunded 51 13
	60'-3/4" Copper tubing @ .384	23 04			Mon Charge 48 85
	1-3/4" Cx 3/4" I.W.F. stop & waste	4 00		8/26/55	Labor 1 85
	1-2/3 hrs. Littlefield Shovel @ 7.50	12 50			12'-3/4" Copper tubing @ .384 4 61
	1 hr. trucking @ .75	75			1-3/4" C. Corp Cock 4 33
	3x3 Patch	3 00			1-3/4" Cx 3.4" C. Curb cock 4 67
			48 85		1 Box & Rod 3 90
					1-1/2" straight tail piece 50
					1-1/2" offset tail piece 50
					1/3 hr. Littlefield Shovel @ 7.50 2 50
					1 hr. trucking @ .75 75
					23 61

DATE _____

TOWN OF LEXINGTON — BOARD OF PUBLIC WORKS

WATER DIVISION

Sketch of Service Here

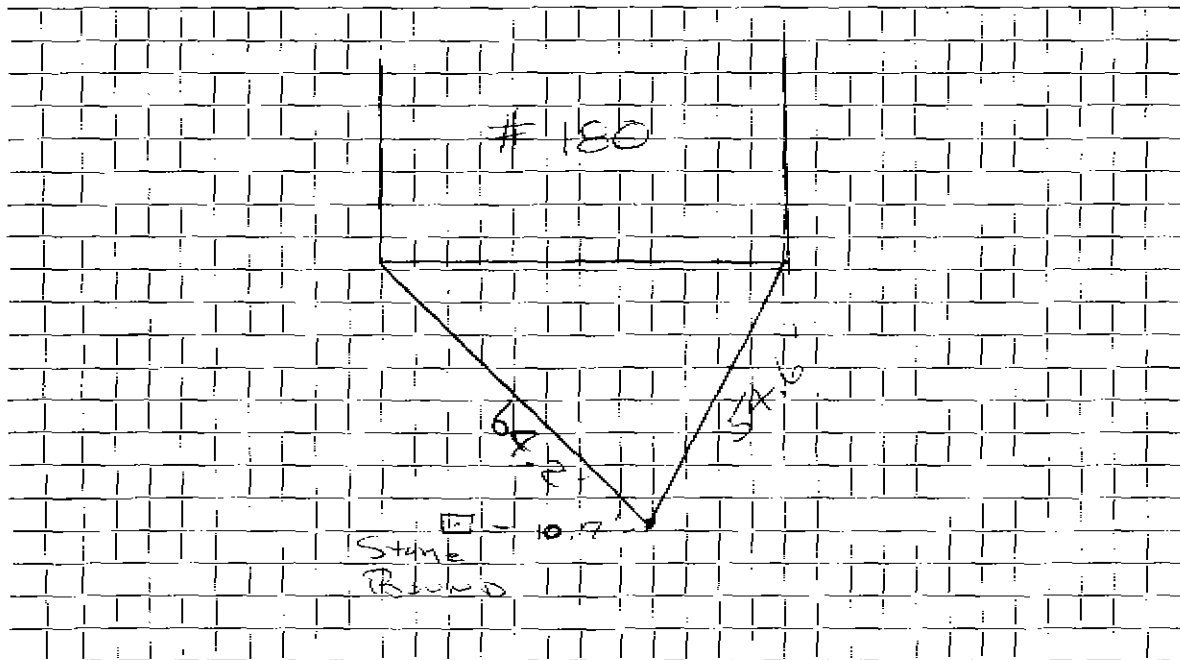

Connection made in Street. Work completed

Remarks:

.....

.....