

# 4429 # 7017

WATER SERVICE RECORD

Service No. 60

Name Richard Flews

Address 188 Grove Street

Location

Repair ~~Renewal~~ — New Service

*Com. 4-11-55*

Date	Material	Amount	Total	Date	Amount
3/14/55	Labor	7 47		3-8-55	Deposited 25 00
	10% overhead	75	8 22	1-3-56	Paid (21 47)
	60' - 3/4" copper tubing @ .35	21 00			NON CHARGE 56 47
	1 - 3/4" C x 1/2 I.W.E. stop & waste	4 00		3/14/55	Labor 6 00
	3 hrs. Littlefield shovel @ .50	22 50			10' - 3/4" copper tubing @ .35 3 50
	1 hr. trucking	75			1 - 3/4" C. corp-cock 4 33
			56 47		1 - 3/4" C. curb-cock 4 67
					1 box and rod 3 00
					1 - 1/2 offset tail piece 50
					1 - 3/8 straight tail piece 50
					2/3 hr. Littlefield shovel @ .75 5 00
					1 hr. trucking 75
					29 15


*Bill sent 4-11-55*

DATE \_\_\_\_\_

TOWN OF LEXINGTON — BOARD OF PUBLIC WORKS

WATER DIVISION

Sketch of Service Here

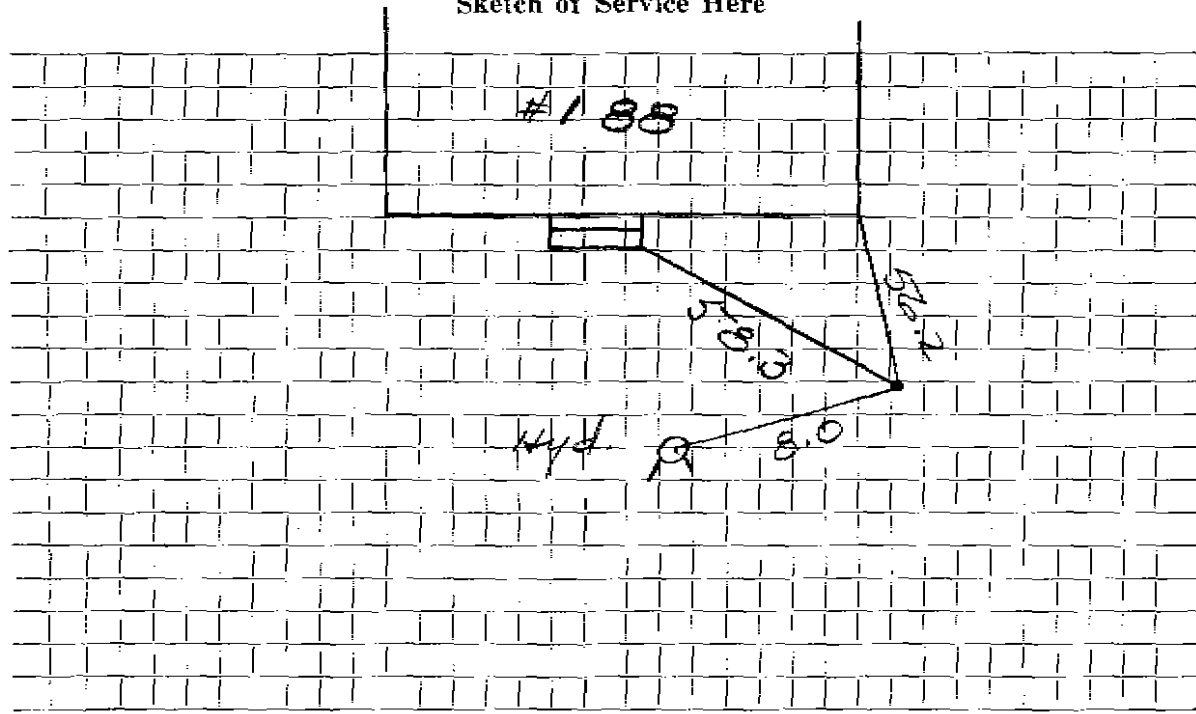

Connection made in ..... Street. Work completed .....

Remarks: .....

.....  
.....