

Name Howard E. Whitehouse

Service No.

5084

Address 189 Grove Street

Lexington, Mass.

Location 189 Grove Street

Kind of Pipe

Size

Size of Main

~~Repair~~ ~~Renewal~~ ~~New Service~~

Location

Date	Material	Amount	Total	Date	Amount
Nov. 23, '48	Labor	1 05		Nov. 1 '48	9 00
24	"	4 25	5 30	Dec 1 '48	32 45
	10% Overhead		53		57 91
	68' - 3/4" Copper tubing @ .255	17 34		Nov. 24, '48 Labor	4 25
	1 - 3/4" C x 3/8" I.W.R. S & W	3 15		36' - 3/4" Copper tubing @ .255	9 18
	2 - 3/4" C x 3/4" C Union (3pts)	2 64		1 - 3/4" C Corp-cock	3 00
	Shovel 1/2 hrs. @ 7.00	28 00		1 - 3/4" C x 3/4" C Curb-cock	3 68
	Trucking 1 hr. @ .75	75		1 - 3/4" C x 3/4" C Unions (3pts)	1 32
			57 71	1 - 1/2" Offset Tail Piece	30
				1 - 1/2" Straight Tail Piece	30
				Shovel 2 hrs. @ 7.00	14 00
				Trucking 1 hr. @ .75	75
	Labor			1 - Box & Rod	3 55
					40 33

Deposited
Deposited
Non-Charge

DATE _____

TOWN OF LEXINGTON - BOARD OF PUBLIC WORKS

WATER DIVISION

The undersigned applies for a supply of water at No. St. and hereby agrees to comply with the rules and regulations as now, or at any future time, established by the Board of Selectmen.

Am't of Estimate \$.....

Owner


Am't Paid \$.....

Address

Builder

.....

Sketch of Service Here *in Dr. way*

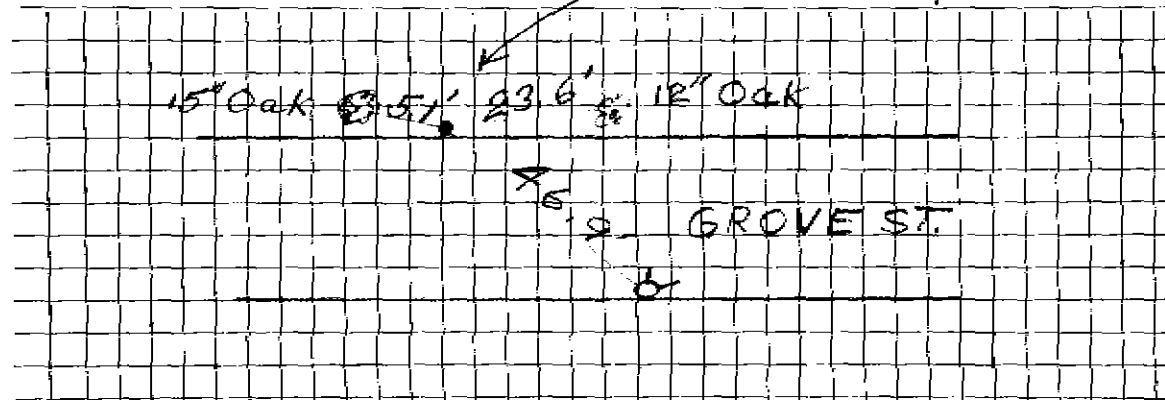

Connection made in Street.

Work completed19

Remarks: