

Name Orrin Brawn

Service No. 187

#4135

Address 191 Grove Street
Lexington, Mass.

Location 191 Grove Street

Kind of Pipe

Size

Size of Main

~~Repair~~ Renewal—New Service

Com. 11-6-50

Location

Date	Material	Amount	Total	Date	Amount
Aug. 8, '50	Labor	5 00	5 00		
	10% Overhead		50		
	76' - 3/4" Copper Tubing	8.275	20 90		
	1 - 3/4" x 1/2" I.W.F. S&W		3 29	Aug. 8, '50	Labor
	1 - 3/4" x 3/4" Union (3pds)		1 39		6 07
	Littlefield Shovel 1 hrs.	7.00	28 00		38' - 3/4" Copper Tubing
	Trucking 1 hr.	2.75	75		8.275
	Patching 26 x 3		26 00		1 - 3/4" Corp-cock
			85 83		3 15
					1 - 3/4" x 3/4" Curb-cock
					3 85
					1 - Box & Rod
					3 35
					1 - 1/2" Offset Tail Piece
					42
					1 - 1/2" Straight Tail Piece
					42
					Littlefield Shovel 2 hrs.
					7.00
					Trucking 1 hr.
					2.75
	Labor				42 46

Hadley Press, Inc., Lexington

DATE _____

TOWN OF LEXINGTON—BOARD OF PUBLIC WORKS

WATER DIVISION

The undersigned applies for a supply of water at No. _____ St. and hereby agrees to comply with the rules and regulations as now, or at any future time, established by the Board of Selectmen.

Am't. of Estimate \$ _____


Owner _____

Am't. Paid \$ _____

Address _____

Builder _____

Sketch of Service Here

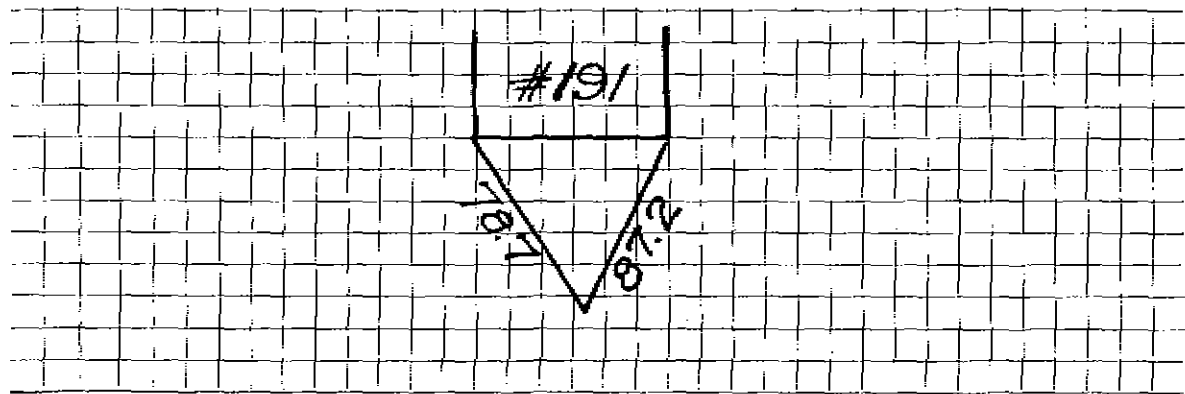

Connection made in _____ Street.

Work completed _____ 19

Remarks: