

WATER SERVICE RECORD

3293

Name Nunzio A. Camerato

Service No. 77

Address 194 Grove Street

Location

~~Repair - Renewal~~ - New Service

Comm. 9-3-57


Date	Material	Amount	Total	Date	Amount
5/11/57	Labor	16 23		4-25-57	Deposit \$100 00
	10% overhead	1 62	17 85	9-3-57	Refund 51 05
	37' - 3/4" Copper tubing @ .4228	15 64			NON CHARGE 48 95
	1 - 3/4" Cx 1/2 I.W.H. Stop & Waste	4 96			Labor 16 71
	1 hr. Trucking		75		13' - 3/4" Copper tubing @ .4228 5 50
	1 1/2 hr. Town Shovel @ 6.50		9 75		1 - 3/4" C. Corp Cock 4 64
			48 95		1 - 3/4" C. Curb Cock 5 94
					1 Box & Rod 4 62
					1 - 3/8 Straight tailpiece 50
					1 - 3/8 Offset tailpiece 50
					1/2 hr. Town Shovel @ 6.50 3 25
					41 66

TOWN OF LEXINGTON — BOARD OF PUBLIC WORKS

WATER DIVISION

DATE _____

Sketch of Service Here

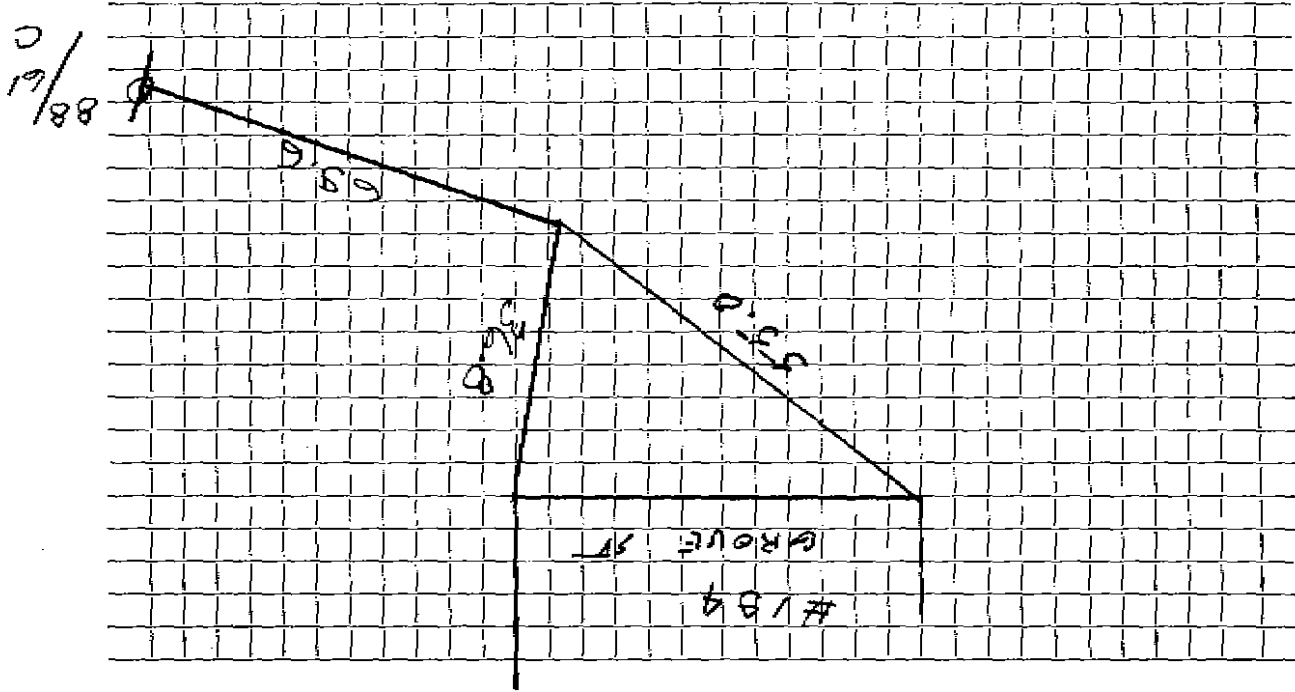

Connection made in _____ Street. Work completed _____

Remarks: _____