


DATE _____

TOWN OF LEXINGTON — BOARD OF PUBLIC WORKS
WATER DIVISION

Sketch of Service Here

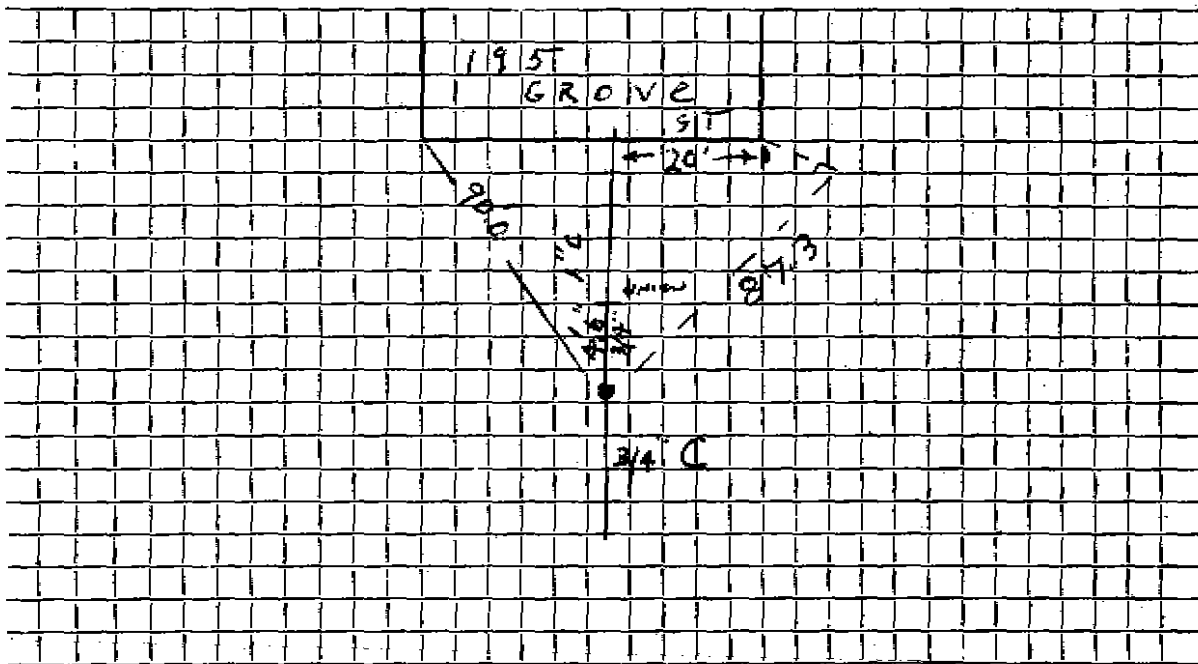

Connection made in Street.

Work completed 5/9/66 J. Maloney, Supt.

Remarks: Tear Down.....
.....
.....