

WATER SERVICE RECORD

Name John O. DeMurs

Service No. 254

Address 198 Grove Street

3054

Location

~~Repair/Renewal~~ - New Service

Comm. 12-13-54


Date	Material	Amount	Total	Date	Amount
11/1/54	Labor	11 78		10-13-54 Deposited	60 00
	20% overhead	1 18	12 96	12-13-54 Refunded	(4 04)
	45' - 3/4" copper tubing @ .35	15 75		<u>NON CHARGE</u>	55 90
	1 - 3/4" C x 1/2 I.W.H. stop & waste	4 00		11/1/54 Labor	11 79
	3 hrs. Littlefield shovel @ 7.50	22 50		10' - 3/4" copper tubing @ .35	3 50
	1 hr. trucking	75	55 96	1 - 3/4" C. corp-cock	4 33
				1 - 3/4" C. curb-cock	4 67
				1 box and rod	3 90
				1 - 1/2 offset tail pc.	50
				1 - 1/2 straight tail pc.	50
				1-2/3 hrs. Littlefield shovel @ 7.50	12.50
				1 hr. trucking	75
					42 44

DATE _____

TOWN OF LEXINGTON — BOARD OF PUBLIC WORKS

WATER DIVISION

Sketch of Service Here

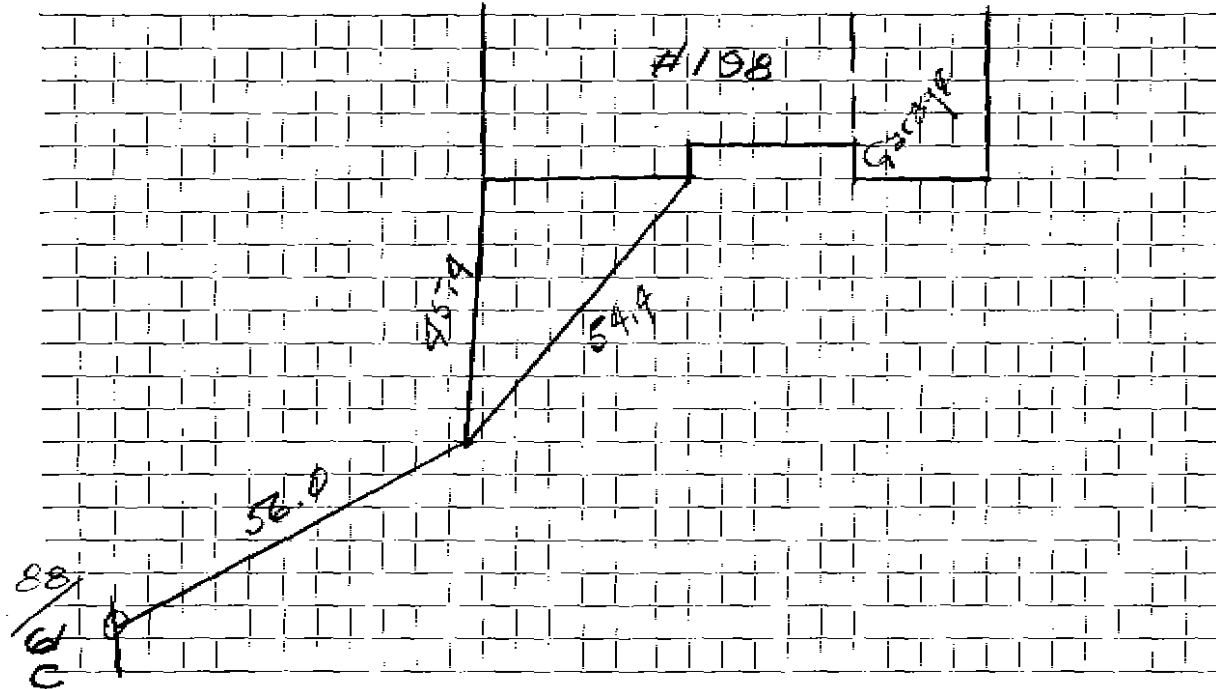

Connection made in Street. Work completed

Remarks:

.....

.....