

Name James D. Howard
 Address 199 Grove Street
 Lexington, Mass.

Service No.

223

Location 199 Grove Street

Kind of Pipe

Size

Size of Main

~~Repair~~ ~~Renewal~~ New Service

Location

Date	Material	Amount	Total	Date	Amount
Sept. 28, '48	Labor	2 10	2 10	Sept 25 '48	50 00
	10% Overhead		22	Oct 22 '48	9 57
	98' - 1" Copper Tubing @.31	30 38	38		<u>40 43</u>
	1 - 1" C x 3/4" I.W.E. S&W	3 15	15	Sept. 28, 1948	4 20
	2 - 1" C x 1" C Unions (3pts)	3 43	43	39' - 1" Copper Tubing @.31	12 09
	1 - 3/4" x 1/2" Bushing	35	35	1 - 1" C Corp-cock	3 96
	Trucking 1 hr. @.75	75	75	1 - 1" C x 1" C Curb-cock	4 80
			40 43	1 - Box & Rod	3 55
				1 - 1/2" Offset Tail Piece	30
				1 - 1" straight Tail Piece	30
				Littlefield shovel 2 hrs. @7.00	14 00
				Trucking 1 hr. @.75	75
				Broken by cont 9/26/61	7' copper
					2 1" Unions
					1 1" Curb Cock
					43 95

Comm. 10/25/48

trench dug by owner

Labor

Broken by cont

Deposited
 Refunded
 Non-Charge

Hadley Press, Inc., Lexington

DATE _____

TOWN OF LEXINGTON—BOARD OF PUBLIC WORKS

WATER DIVISION

The undersigned applies for a supply of water at No. _____ St. and hereby agrees to comply with the rules and regulations as now, or at any future time, established by the Board of Selectmen.

Am't. of Estimate \$ _____


Owner _____

Am't. Paid \$ _____

Address _____

Builder _____

Sketch of Service Here

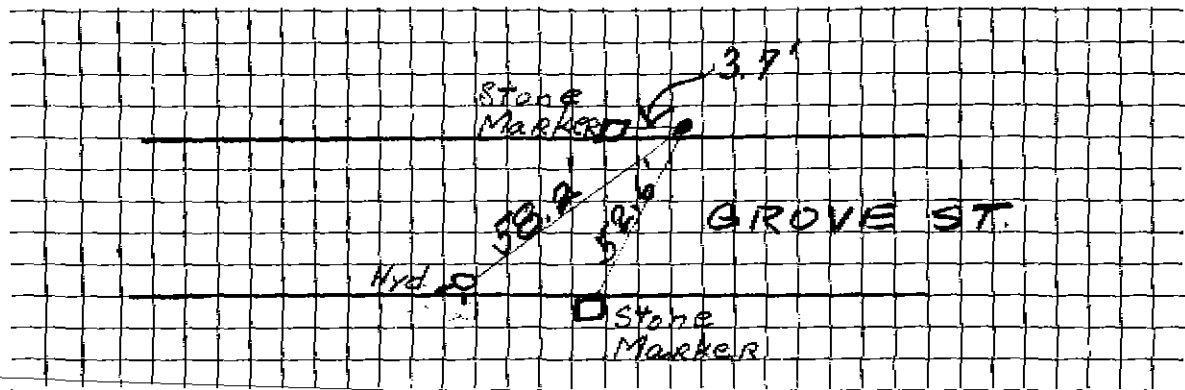

Connection made in _____ Street. Work completed _____ 19

Remarks: