

## WATER SERVICE RECORD

Name Johnstone Fitzgerald

Service No. 75

Address 200 Grove Street

Location

~~REWORK PROJECT~~ - New Service

Conn 7560


Date	Material	Amount	Total	Date	Amount	
5-26-60	Labor	46 41		5-27-60	Deposit	100 00
	10% O.H.	4 64	51 05	7-20-60	Paid	14 14
78'	3/4" Copper tubing @42		32 76			114 14
1	3/4" Cx 1/2 I.B.H. Stop&Waste		6 17		<u>NO CHARGE</u>	
1	3/4" C3 part union		2 41		Labor	5 36
3 1/2	Hours Town Shovel @4.50		15 25	9'	3/4" Copper tubing @42	7 02
2	Hours Trucking @3.00		6 00	1	3/4" C Corp Cock	4 91
			114 14	1	3/4" C Curb Cock	6 28
				1	Box & Rod	5 00
				1 1/8	Straight tailpiece	50
				1 1/8	Offset tailpiece	50
						29 57

DATE \_\_\_\_\_

TOWN OF LEXINGTON — BOARD OF PUBLIC WORKS

**WATER DIVISION**

Sketch of Service Here

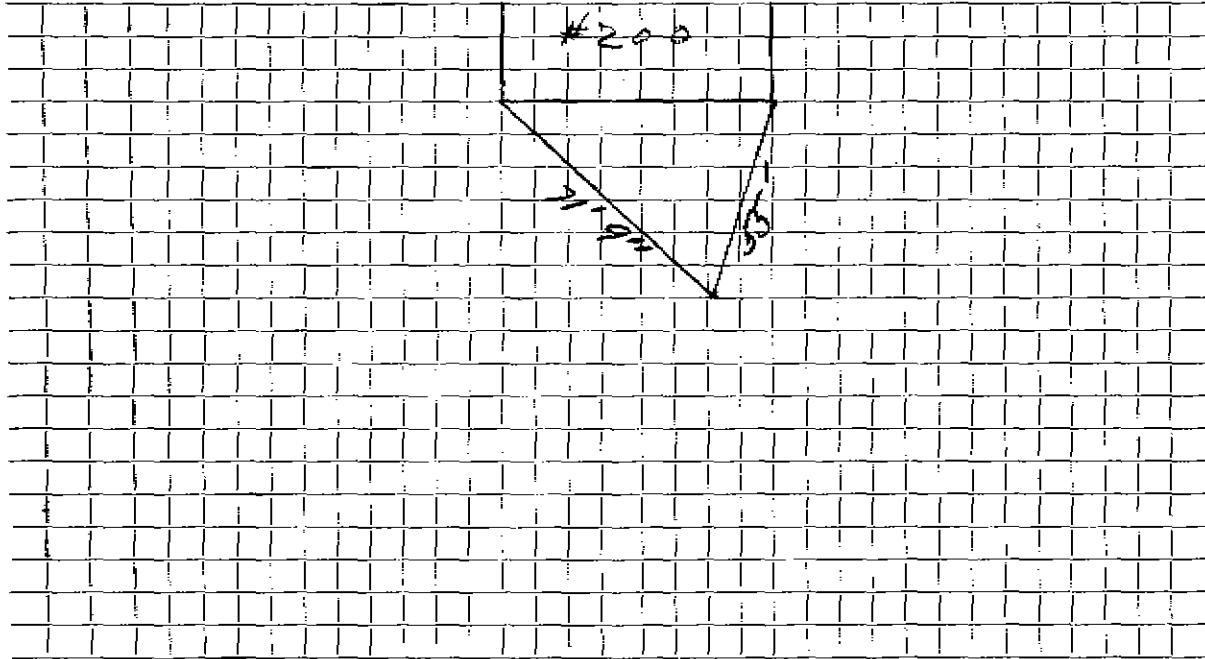

Connection made in ..... Street. Work completed .....

Remarks: .....

.....

.....