

WATER SERVICE RECORD

Name James J. Delaney

Service No. 74

Address 203 Grove Street

Location

~~Repair~~ - New Service*Com. 6-1-54*


Date	Material	Amount	Total	Date	Amount
4/27/54	Labor	8 64		4-12-54 Deposited	75 00
	10% Overhead	86	9 50	6-1-54 Refunded	2 28
	75' 3/4" Copper tubing @ .35	26 25		<u>NON CHARGE</u>	72 22
	1 - 3/4" Cx 1/2" I.W.H. stop & waste	4 00	4/27/54 Labor		15 00
	1 - 3/4" Cx 3/4" C. Union	1 72	30' - 3/4" Copper Tubing @ .35		10 50
	2 hrs. Littlefield Shovel @ 7.50	15 00	1 - 3/4" C. corp-cock		4 33
	1 hr. Trucking	75	1 - 3/4" C. x 3/4" C. curb-cock		4 67
	Patching 15x3	15 00	1 Box & Rod		3 90
		72 22	1 - 1/2 straight tail piece		50
			1 - 1/2 offset tail piece		50
			1 hr. Trucking		75
			<i>Broken by Cut</i> 9/27/61 6' 3/4 COPPER		40 15
			1 78 UNION		
			1 3 PART UNION		
			1 3/4 CURB COCK		

DATE _____

TOWN OF LEXINGTON — BOARD OF PUBLIC WORKS

WATER DIVISION

Sketch of Service Here

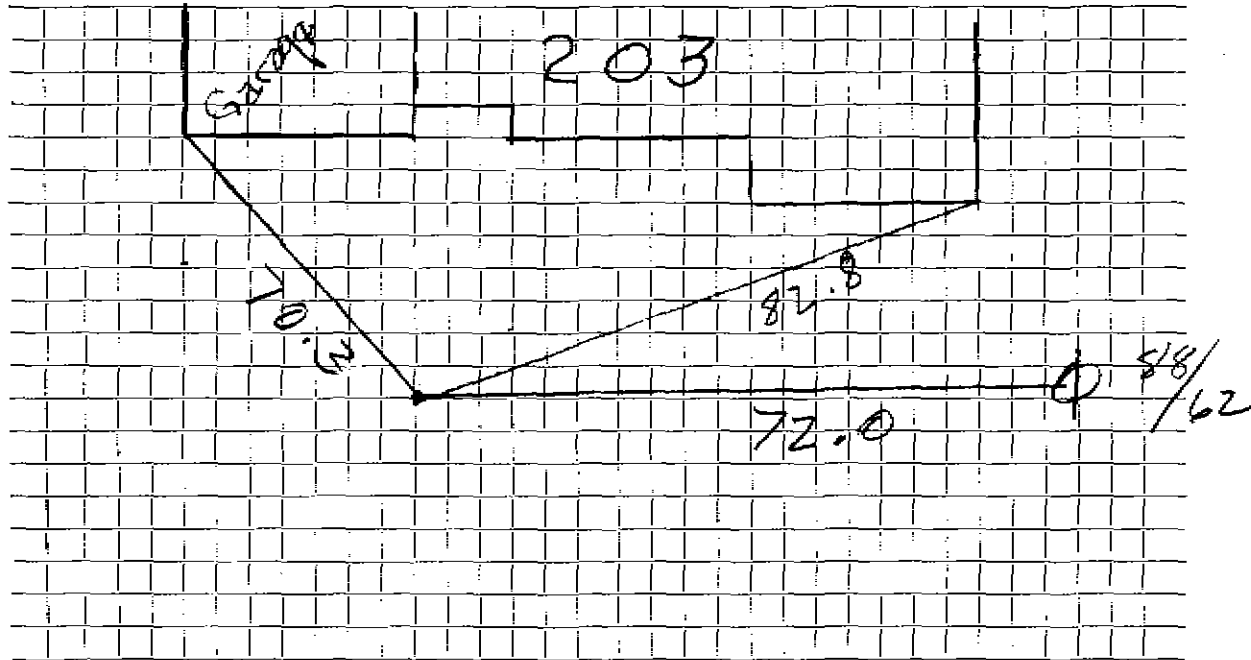

Connection made in Street. Work completed

Remarks:
.....
.....