

Name Gustaf Headberg

Service No. 219

Address 205 Grove Street

Lexington, Mass.

Location 205 Grove Street

Kind of Pipe

Size

Size of Main

~~Repair~~ ~~Renewal~~ New Service

Location

Date

Material

Amount

Total

Date

Amount

Sept. 28, '48	Labor	13 90	13 90	Sept 28 '48	Deposited	80 00
	100' Overhead		1 39	Oct 28 '48	Refunded	15 40
	72' - 1" Copper Tubing @.31		22 32		Non-Charge	<u>64 60</u>
	1 - 1" C x 3/4" I.W.F. S&W		3 15	Sept. 28, '48	Labor	5 00
	1 - 1" C x 1" C Union(3pts)		1 74	30' - 1" Copper Tubing @.31		9 30
	1 - 3/4" x 1/2" Bushing		35	1 - 1" Corp-cock		3 96
	Littlefield Shovel 3 hrs. @7.00	21 00	21 00	1 - 1" C x 1" C Corp-cock		4 80
	Trucking 1 hr. @.75		75	1 - 1" C x 1" C Union(3pts)		1 74
			<u>64 60</u>	1 - Box & Rod		3 55
				1 - 1/2" Offset Tail Piece		30
				1 - 1/2" Straight Tail Piece		30
				Shovel 2 hrs. @7.00		14 00
				Trucking 1 hr. @.75		75
				Broken by cont. 9/61	6' 1" COPPER	43 70
					1 88 UNION	
					1 3PART UNION	
					1 1" CORB COCK	

Com. 10/25/48

Labor

Hadley Press, Inc., Lexington

DATE _____

TOWN OF LEXINGTON—BOARD OF PUBLIC WORKS

WATER DIVISION

The undersigned applies for a supply of water at No. _____ St. and hereby agrees to comply with the rules and regulations as now, or at any future time, established by the Board of Selectmen.

Am't. of Estimate \$ _____


Owner _____

Am't. Paid \$ _____

Address _____

Builder _____

Sketch of Service Here

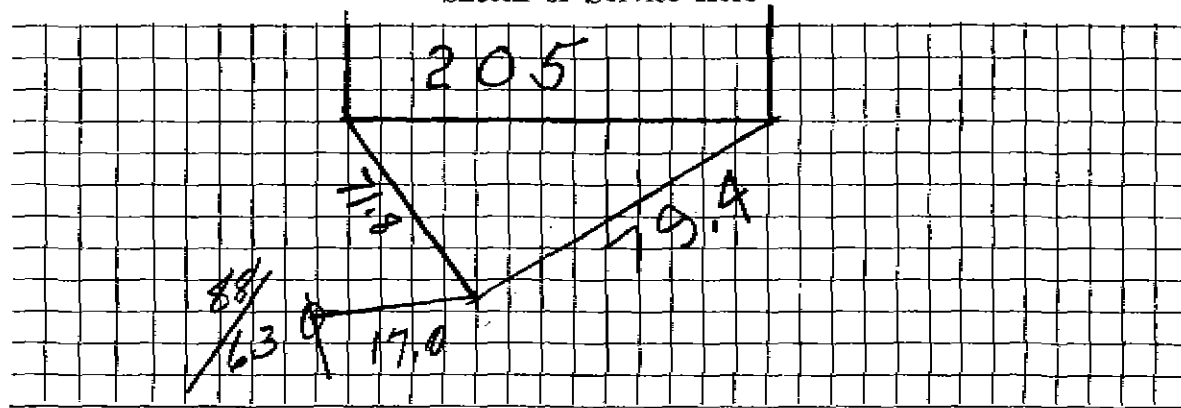

Connection made in _____ Street.

Work completed _____ 19

Remarks: