

WATER SERVICE RECORD

4445

4970

Name Johnstone Fitzgerald

Service No. 10

6275

Address 208 Grove Street

7646

Location

~~Repair~~ New Service

W.O. #8557

DEC 28 1964


Date	Material	Amount	Total	Date	Amount
7-20-64	Labor	2 68		2-11-44	160 00
	10% O.H.	27	2 95	12-28-64	122 56
	60' 3/4" Copper Tubing @ .42		25 20		37 44
	1 3/4" CX 1/2 I.W.H. Stop & Waste		9 29		
			37 44		
					NON CHARGE
				7-20-64	Labor 2 05
					6" 3/4" Copper Tubing @ .42 2 52
					1 3/4" C Corp Cock 7 41
					1 3/4" C Curb Cock 8 76
					1 Box & Rod 4 90
					1 1/2 Straight Tailpiece 50
					1 1/2 Offset Tailpiece 50
					26 64

TOWN OF LEXINGTON — BOARD OF PUBLIC WORKS

WATER DIVISION

DATE _____

Sketch of Service Here

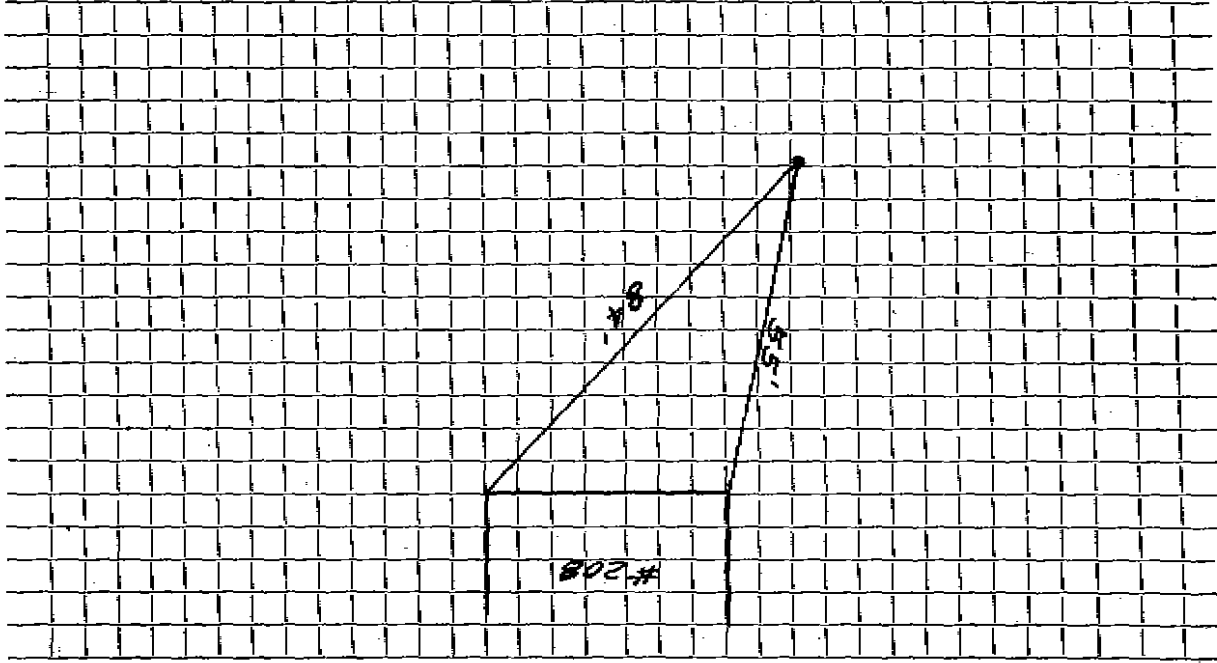

Connection made in

Street

Work completed

Remarks: