

WATER SERVICE RECORD

Name Raymond Carchia

Service No. 196

Address 209 Grove St.

Location Lexington

Repair/Renewal - New Service

Com. F-31-53


Date	Material	Amount	Total	Date	Amount
8/4/53	Labor	3 50		7-16-53	Deposited 55 00
	10% overhead	35	3 85	8-31-53	Refunded 2 37
	67' - 3/4" Copper Tubing @ .3629		24 31		NON CHARGE 52 63
	1-3/4" C x 1/2 I.W.H. STOP & WASTE		4 00	8/4/53	Labor 34 00
	1-3/4" C x 3/4" G. Union (3 parts)		1 72		30' - 3/4" Copper Tubing @ .3629 10 89
	1 Hr. Trucking		75		1-3/4" C. Corp-cock 4 33
	Patching 18 x 3		18 00		1-3/4" C x 3/4" C. Curb-cock 4 67
			52 63		1-Box & Rod 3 90
	TRENCH DUG BY OWNER				1-1/2 offset tail piece 50
					1-1/2 straight tail piece 50
					3 Hrs. Littlefield Shovel @ 7.50 22 50
					1 Hr. Trucking 75
					Broken Conti 82 04
				9/61	61' 3/4 COPPER
					1 3/4 Curb
					1 3/4 88 UNION

DATE _____

TOWN OF LEXINGTON - BOARD OF PUBLIC WORKS

WATER DIVISION

Sketch of Service Here

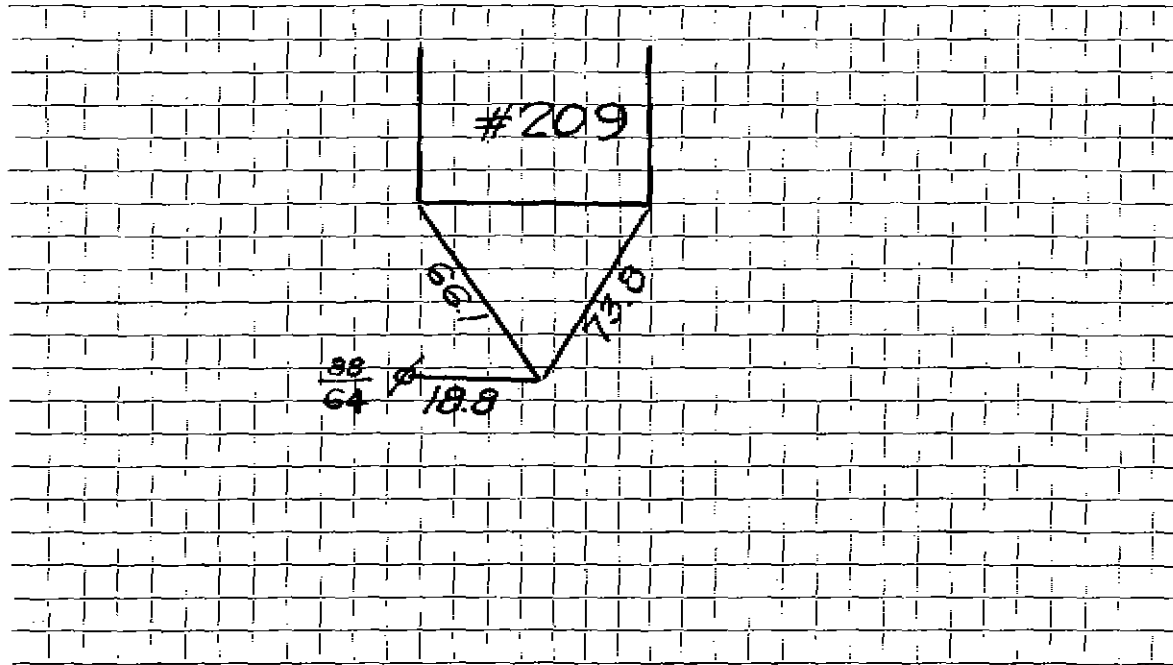

Connection made in Street. Work completed

Remarks:

.....

.....

20