


DATE _____

TOWN OF LEXINGTON — BOARD OF PUBLIC WORKS
WATER DIVISION

#222 GROVE ST.

Sketch of Service Here

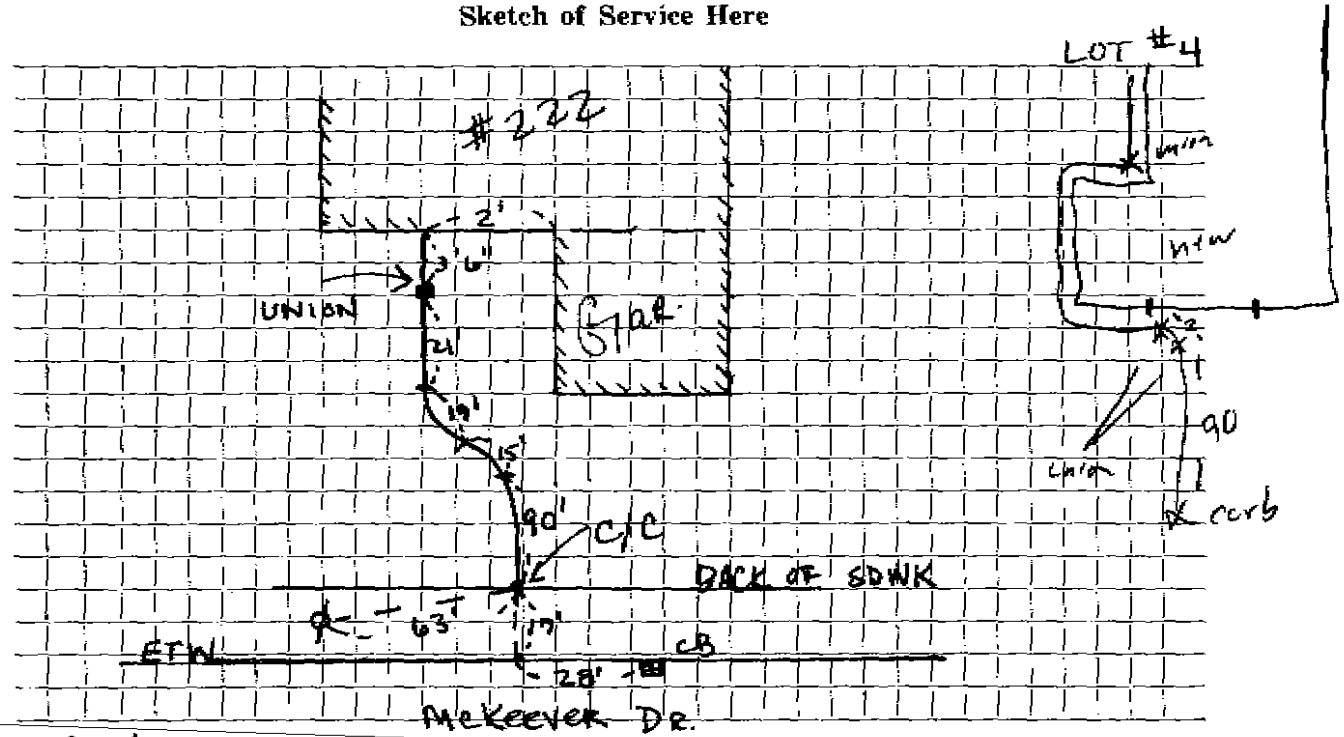

Connection made in McKeever Dr. Street. Work completed _____

Remarks: NO OUTSIDE TIES HOUSE OFF OF GROVE ST.