

#6131

WATER SERVICE RECORD

Name John J. Carchia

Service No. 106

Address 223 Grove Street

Location

~~Repair Request~~ - New Service Anthony Cardillo Permit #A-39 W.O. #1105


MAR 14 1966

Date	Material	Amount	Total	Date	Amount
10-18-65	Labor	27 51		11-11-65	175 00
	10% O.H.	2 75	30 26	3-15-66	59 85
22'	1" copper tubing @ .56		12 32		115 95
1	1" Corp		10 66		
1	1" Curb		11 15		
1	Box & Rod		4 90		
	20 x 4 Patch		26 66		
1	Hr. Town Truck		3 00		
1	Hr. Loader		4 00		
2	Hrs. Town SShovel @ 6.50		13 00		
			115 95		
11-5-65	68' 1" Copper tubing				

DATE _____

TOWN OF LEXINGTON — BOARD OF PUBLIC WORKS
WATER DIVISION

Sketch of Service Here

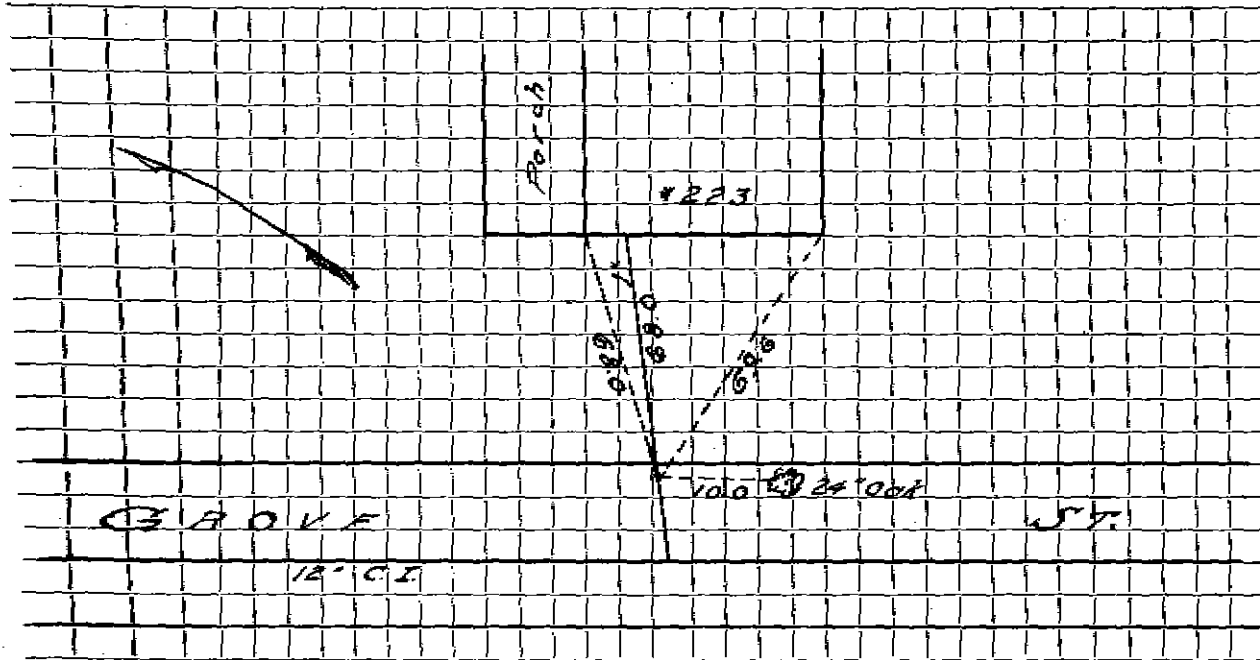

Connection made in Street. Work completed

Remarks:
.....
.....