

Name R. Garchia
 Address 225 Grove Street
 Lexington, Mass.

Service No. 196

Location 225 Grove Street - Pit

Kind of Pipe

Size

Size of Main

~~Repair - Renewal~~ New Service

Com. 11-6-50

Location

Date	Material	Amount	Total	Date	Amount
Aug. 24, '50	Labor	1 30	1 30	July 24, '50	30 00
	10% Overhead		13	7, 6, 9, '50	12 00
	7' - 3/4" Copper Tubing @.275	1 93	1 93		33 30
	1 - 3/4" C x 1 1/2" I.W.H. S&W	3 29	3 29	Aug. 24, '50	Labor
	Littlefield Shovel 1 hr. @ 7.00	7 00	7 00	33' - 3/4" Copper Tubing @.275	9 08
	Trucking 1 hr. @ .75	75	75	1 - 3/4" C Corp-cock	3 15
	Patching 20 x 3	20 00	20 00	1 - 3/4" C x 3/4" C Gurb-cock	3 85
	Service connected where pit was remov.	34 40	34 40	1 - Box & Rod	3 35
7/22/80	Labor			1' - 15" Concrete Pipe @ 2.00	8 00
2'	3/4" Copper			1 - Pit Cover & Frame	13 00
1	3/4" 3 part union			1 - 3/8" Offset Tail Piece	42
1	style 88 coupling			1 - 1/2" Straight Tail Piece	42
	Labor loam, seed & fertilizer			Littlefield Shovel 3 hrs. @ 7.00	21 00
				Trucking 1 hr. @.75	75
					80 02

Hadley Press, Inc., Lexington

DATE _____

TOWN OF LEXINGTON—BOARD OF PUBLIC WORKS

WATER DIVISION

The undersigned applies for a supply of water at No. _____ St. and hereby agrees to comply with the rules and regulations as now, or at any future time, established by the Board of Selectmen.


Am't. of Estimate \$ _____

Owner _____

Am't. Paid \$ _____

Address _____

Builder _____

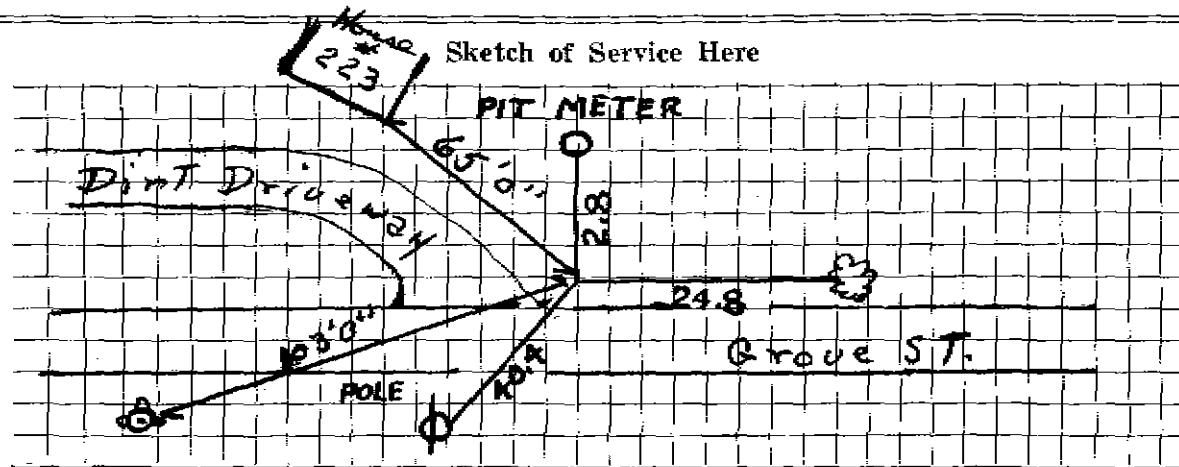

Connection made in _____ Street.

Work completed _____ 19__

Remarks: *This curb box is located before driveway of house # 223
Pit meter + pit has been removed.*